


Section 26 Township 12 Range 18W

Well No. #1 Schmidt

Company Rine Drlg.

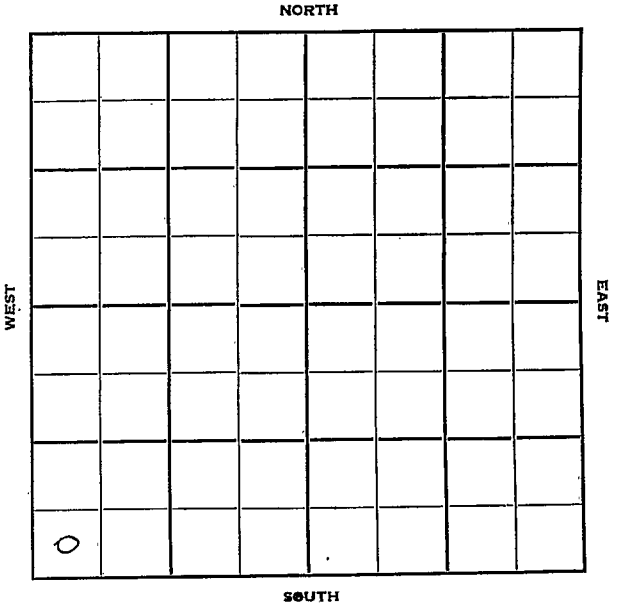

Ellis

Sec. 26 Twp. 12 R. 18 W ✓

Well No. # 1 Schmidt Farm

Rine Drlg. Company

Contractor

Wildcat


 Ft. from N. Line

330 Ft. from S. Line

 Ft. from E. Line

330 Ft. from W. Line

SW SW SW

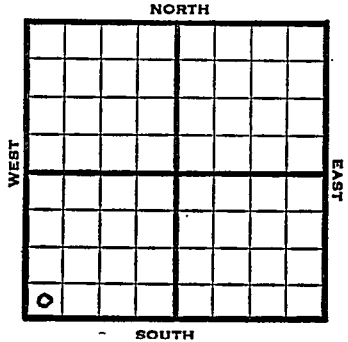

1951 Elev. 2115' REPORT

3/14 Location

3/28 Spud 3-16-51
 D & A TD 3720'
 10" @ 195' Anhy 1980', Top. 3098',
 Heeb. 3357', Lans. 3405'
 DST 3448-88' open 45 min. Rec. 20'
 mud, B KC 3632', Cong. 3672'
 TD 3720' D & A

ABANDONED

