

Section 26 Township 12 Range 18 W

Well No. # 1 Stackhouse

Company Petroleum Inc

NORTH

			0				

WEST

EAST

SOUTH

Ellis

KANSAS ✓

Sec. 26 Twp. 12 R. 18 W

Well No. # 1 Stackhouse Farm

Petroleum Inc. Company

Garvey Contractor

Koblitz Pool


Ft. from N. Line

990 Ft. from S. Line

330 Ft. from E. Line

Ft. from W. Line

NE SE NW

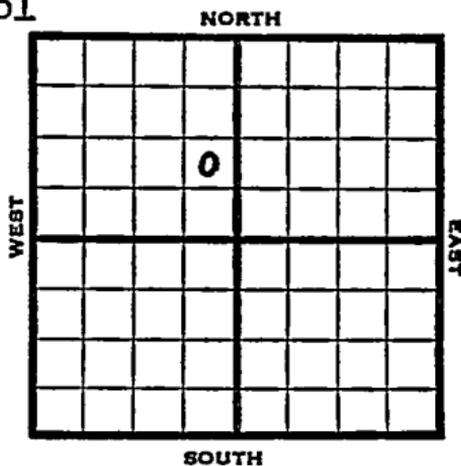

1953 Elev. 2162' REPORT

6/17 RUR

6/24 8" @ 193 Anhy 1412  
Heeb 3383 Drlg. 3492

7/1 Spud 6-15-53 D & A TD 3715  
8" @ 193 Anhy 1412 Heeb 3383  
Lans 3429  
DST 3461-70 open 1/2 hr rec 6' mud  
DST 3487-3535 open 1/2 hr rec 14' mud  
870# Cong. 3683 TD 3715  
D & A

**ABANDONED**


County Ellis State Kansas

Sec. 26 (Blk. Twp.) 12 (Sur. Rge.) 18W Map No.

Operator Petroleum Inc.

Well No. 1 Farm Stackhouse

Elev. \_\_\_\_\_ Location NE SE NW

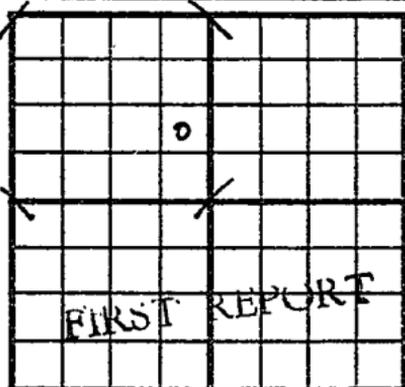

990 Ft. From S Line NW

330 Ft. From E Line Quarter.

Ist. Report JUN 17 1953

Completion \_\_\_\_\_

Remarks \_\_\_\_\_

Garvey - Contr.

Spudding Date \_\_\_\_\_

Drlg. Data Koblitz Pool

RUR

J. G. McGEHEE

