

KANSAS


Ellis

FORM 51 IOM 12-46 PETROL

Section 26 Township 12 Range 18W

Well No. 1 Stackhouse

Company Doley Oil

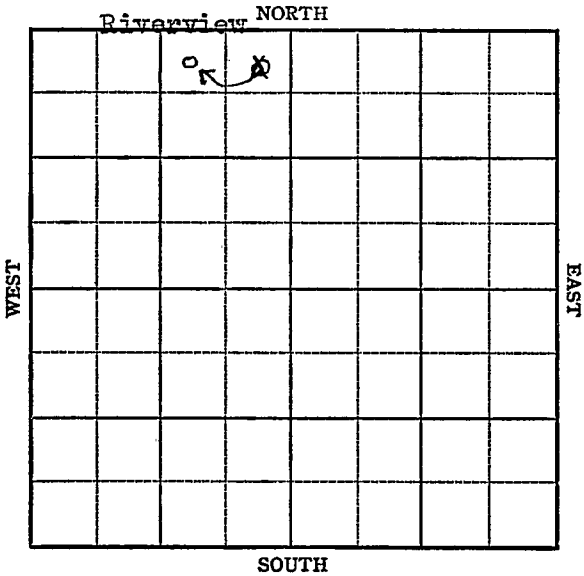

KANSAS Ellis

Sec. 26 Twp. 12 R. 18W

Well No. #1 Stackhouse Farm

Doley Oil Company

Riverview

330 Ft. from N. Line


 Ft. from S. Line

990
330 Ft. from E. Line

 Ft. from W. Line

~~NE NW~~

NW NE NW

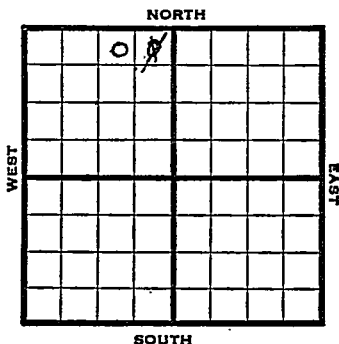

1947

Elev. 2158' REPORT

8/27

Location

9/3

"

9/10

"

9/17

10" @ 56'
Drlg. 1240'

9/24

Anhydrite 1405'
Drlg. 2740'

10/1

Lansing 3410'
Drlg. 3547'

10/8

Conglomerate 3679'
TD 3728' in Cong.

10/15

5" @ 3544'
RUST

10/22

Plug 3501
12 shots 3484-88, no shows
12 " 3490-94 swb
1 1/2 bbls oil & 1/2 W PH, 6 hrs.

11/5

Cong. 3679'
5" @ 3544'
Total Depth 3723'

ABANDONED

Map No. _____ Sec. 26 Twp. 12 R. 18W

Well No. 1 Stackhouse


Doley Oil Company

FIRST REPORT

Contractor _____

NE NW

SECTION PLAT

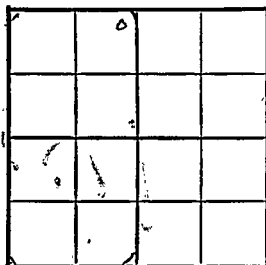

330 Ft. from N. Line

_____ Ft. from S. Line

330 Ft. from E. Line

_____ Ft. from W. Line

Ellis County

Location X

Rig up _____

Drilling and Remarks:

RECORD

Cased _____ in., _____ ft.

Sand _____

Gas _____

Oil _____

Total Depth _____

PRODUCTION

1st 24 hrs. Nat. _____

1st 24 hrs. after shot _____

Gas _____ Cu. Ft.

Dry Hole _____

Abandoned _____

Date

AUG 27 1947 19 S. J. LEWIS Scout

Map No. 71 Sec. 26 Twp. 12 R. 18W

Well No. 1 Stackhouse

Doley Oil

Company

CORRECTION

Contractor

NW NE NW

SECTION PLAT

330 Ft. from N. Line

 Ft. from S. Line

990 Ft. from E. Line

 Ft. from W. Line

	0		

Ellis County

Location

Rig up

Drilling and Remarks:

Reported

NE NW

RECORD

Cased in., ft.

Sand

Gas

Oil

Total Depth

PRODUCTION

1st 24 hrs. Nat.

1st 24 hrs. after shot

Gas Cu. Ft.

Dry Hole

Abandoned

Date

SEP 17 1947 19

S. J. LEWIS

Scout

Map No. 71 ^{Kansas} Sec. 26 Twp. 12 R. 18W

Well No. 1 Stackhouse

Doley Oil Company

ABANDONED

Contractor

NW NE NW


E/2158
SECTION PLAT

330 Ft. from N. Line

 Ft. from S. Line

990 Ft. from E. Line

 Ft. from W. Line

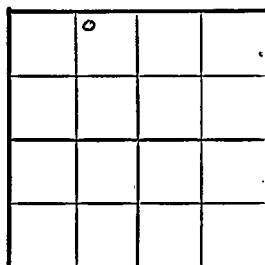

Ellis County

Location

Rig up

Drilling and Remarks:

Con 93679
5" 23544

RECORD

Cased in., ft.

Sand

Gas

Oil

Total Depth 0223

PRODUCTION

1st 24 hrs. Nat.

1st 24 hrs. after shot

Gas Cu. Ft.

Dry Hole

Abandoned

Date

NOV 5 1947 19 S. J. LEWIS Scout