


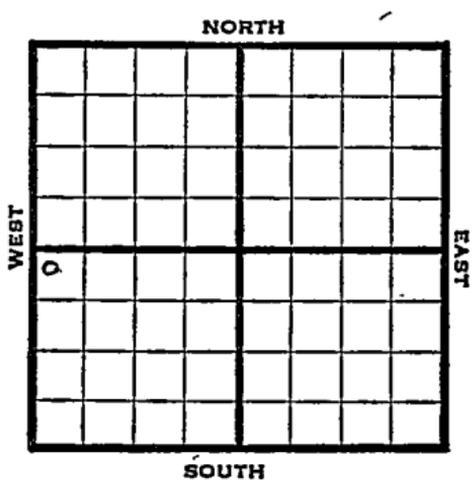

Sec. 27 Twp. 12 R. 17W

Well No. #1 Schmeidler "C" Farm \_\_\_\_\_  
Bay Pet. Company \_\_\_\_\_

**Schmeidler**  
330 Ft. from N. Line  
\_\_\_\_\_ Ft. from S. Line  
\_\_\_\_\_ Ft. from E. Line  
330 Ft. from W. Line



NW SW

1947

Elev. 2112' REPORT

- 9/10 Location
- 9/17 RUR
- 9/24 8" @ 1400'  
Drlg. 3250'
- 10/1 Lansing 3414'  
Arbuckle 3638'  
TD 3642'  
5" @ 3640'  
RUST
- 10/8 Drlg. 3654'  
SSO
- 10/15 TD 3657'  
500 Acid  
Swb 2 bbls oil PH & 20% W.
- 10/22 " "
- 10/29 " "
- 11/5 " "
- 11/12 Arbuckle 3638'  
5" @ 3640'  
500 Acid  
Pump 25 oil & 20% W Pot.  
Gr. 26°  
Total Depth 3657'

**COMPLETED**

Map No. \_\_\_\_\_ Sec. 27 Twp. 12 R. 17W

Well No. 1 Schmeidler "C"

Bay Pet. \_\_\_\_\_ Company \_\_\_\_\_

FIRST REPORT \_\_\_\_\_ Contractor \_\_\_\_\_

NW SW

SECTION PLAT

330 Ft. from N. Line

\_\_\_\_\_ Ft. from S. Line

\_\_\_\_\_ Ft. from E. Line

330 Ft. from W. Line

|  |  |  |  |
|--|--|--|--|
|  |  |  |  |
|  |  |  |  |
|  |  |  |  |
|  |  |  |  |

Ellis County

Location X \_\_\_\_\_

Rig up \_\_\_\_\_

Drilling and Remarks: \_\_\_\_\_

RECORD

Cased \_\_\_\_\_ in. \_\_\_\_\_ ft.

Sand \_\_\_\_\_

Gas \_\_\_\_\_

Oil \_\_\_\_\_

Total Depth \_\_\_\_\_

PRODUCTION

1st 24 hrs. Nat. \_\_\_\_\_

1st 24 hrs. after shot \_\_\_\_\_

Gas \_\_\_\_\_ Cu. Ft.

Dry Hole \_\_\_\_\_

Abandoned \_\_\_\_\_

Date

SEP 10 1947 19

S. J. LEWIS

Scout

Form 26 200 Bks. 10-46 Petrol  
KansasMap No. 71 Sec. 27 Twp. 12 R. 17WWell No. 1 Schmeidler "C"

Bay Pet.

Company

**COMPLETE**

Contractor

NW SW

*E1, 2/12***SECTION PLAT**330 Ft. from N. Line

Ft. from S. Line

Ft. from E. Line

330 Ft. from W. Line

|   |  |  |  |
|---|--|--|--|
|   |  |  |  |
|   |  |  |  |
| o |  |  |  |
|   |  |  |  |

Ellis County

Location \_\_\_\_\_

Rig up \_\_\_\_\_

Drilling and Remarks:

*Cr 88638.*  
*5" 08646*  
*500 acid*  
*Pump 25 oil +*  
*1209 W Bd*

*260 ft***RECORD**

Cased \_\_\_\_\_ in., \_\_\_\_\_ ft.

Sand \_\_\_\_\_

Gas \_\_\_\_\_

Oil \_\_\_\_\_

Total Depth 8657**PRODUCTION**

1st 24 hrs. Nat. \_\_\_\_\_

1st 24 hrs. after shot \_\_\_\_\_

Gas \_\_\_\_\_ Cu. Ft.

Dry Hole \_\_\_\_\_

Abandoned \_\_\_\_\_

Date

NOV 12 1947 19

S. J. LEWIS Scout