


Section 27 Township 12 Range 17 W

Well No. # 2/3 Schmeidler "B"

Company Brunson Drlg.

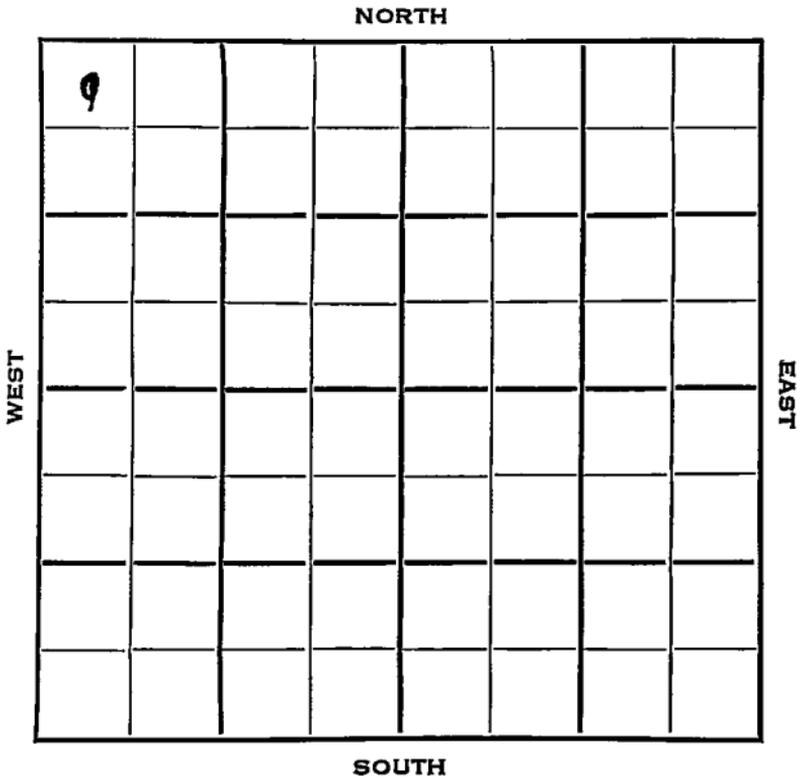

Sec. 27 Twp. 12 R. 17W

Well No. ~~#3~~ <sup>#2</sup> Schmeidler "B" Farm

Brunson Drlg. Company

Pam-Kar Contractor

Schmeidler Pool


330 Ft. from N. Line

\_\_\_\_\_ Ft. from S. Line

\_\_\_\_\_ Ft. from E. Line

330 Ft. from W. Line

NW NW NW (50' SW Twin Well)

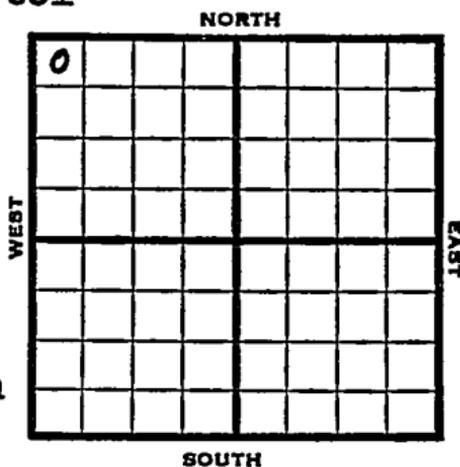

1953 Elev. 2145' REPORT

5/27 Spud 5-20-53  
8" @ 200'  
Anhy 1356'  
Drlg 2726'

6/3 Heeb 3367, Tor 3380, Lans 3428, Arb 3662,  
RTD 3665  
5" @ 3658'

6/10 DD 2674  
FU 11' fluid 11 hrs. 500 A

6/24 Hyd. 4 1/2 BOPH

7/1 NR

7/22 NR

7/29 4 BOPH

8/5 NR

8/12 Spud 5-20-53 Oil well TD 3674  
8" @ 200 Anhy 1356 Heeb 3367  
Tor. 3380 Lans 3428 Arb. 3662  
TD 3665 ~~5"~~ 5" @ 3658 DD 3674  
FU 11' fluid 11 hr. 500 A Hydro.  
4 1/2 BOPH  
Comp. 25 BOPD

**COMPLETED**

County Ellis State Kansas

Sec. 27 (Blk. Twp.) 12 (Sur. Rge.) 17W Map No.

Operator Brunson Drlg.

Well No. 3 Farm Schmeidler

Elev. 2145 Location NW NW NW <sup>50' SW</sup> (twin well)

0							

330 Ft. From N Line NW

330 Ft. From W Line Quarter

Ist. Report MAY 27 1953

Completion \_\_\_\_\_

Remarks \_\_\_\_\_

Pam-Kar - Contr.

Spudding Date 5-20-53

Drlg. Data Schmeidler Pool

8" @ 200 Anhy 1356 drlg. 2726

KANSAS

Map No. \_\_\_\_\_ Sec. 27 Twp. 12 R. 17W

Well No. 2 Schmeidler "B"

Brunson Drlg. Company

**CORRECTION**

Contractor

NW NW NW

**SECTION PLAT**

330 Ft. from N. Line

\_\_\_\_\_ Ft. from S. Line

\_\_\_\_\_ Ft. from E. Line

330 Ft. from W. Line

0			

Ellis County

Location \_\_\_\_\_

Rig up \_\_\_\_\_

Drilling and Remarks:

Reported  
#3 Schmeidler

**RECORD**

Cased \_\_\_\_\_ in., \_\_\_\_\_ ft.

Sand \_\_\_\_\_

Gas \_\_\_\_\_

Oil \_\_\_\_\_

Total Depth \_\_\_\_\_

**PRODUCTION**

1st 24 hrs. Nat. \_\_\_\_\_

1st 24 hrs. after shot \_\_\_\_\_

Gas \_\_\_\_\_ Cu. Ft.

Dry Hole \_\_\_\_\_

Abandoned \_\_\_\_\_

Date

JUN ? 4 1953 19

J. G. MCGEHEE

Scout

County Ellis State Kansas  
 Sec. 27 (Blk.) 12 (Sur.) 17W Map No.  
 Operator Brunson Drlg.  
 Well No. 2 Farm Schmeidler "B"  
 Elev. 2145 Location NW NW NW

0							

330 Ft. From N Line NW330 Ft. From W Line Quarter

1st. Report

Completion AUG 12 1953Remarks Schmeidler PoolPam-Kar - Contr.Spudding Date 5-20-53Drlg. Data Oil well TD 36748" @ 200 Anhy 1356 Heeb. 3367Tor. 3380 Lans. 3428 Arb. 3662TD 3665 5" @ 3658. DD 3674 FU 11'fluid 11 hr. 500 A Hydro. 4½ bophComp. 25 bopd

J. G. McGEHEE