

Section 27 Township 12 Range 17W

Well No. 1 Schneider

Company Brunson Drlg.

Schneider Pool

NORTH

| | | | | | | | |
|--|---|--|--|--|--|--|--|
| | 0 | | | | | | |
| | | | | | | | |
| | | | | | | | |
| | | | | | | | |
| | | | | | | | |
| | | | | | | | |
| | | | | | | | |
| | | | | | | | |

WEST

EAST

SOUTH

Sec. 27 Twp. 12 R. 17W ✓

Well No. #1 Schneidler Farm

Brunson Drlg. Company

Schneidler Pool


330' Ft. from N. Line

_____ Ft. from S. Line

_____ Ft. from E. Line

330' Ft. from W. Line

NW/C

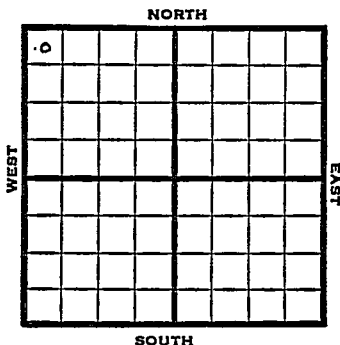

| 1948 | Eley 2145' | REPORT |
|-----------------|-----------------------|--------|
| 10/27 | Location | |
| 11/3 | " | |
| 11/10 | " | |
| 11/16 | 8" @ 200' | |
| | Drlg. 1690' | |
| 11/23 | Drlg 3538' | |
| 11/30 | Arbuckle 3666' | |
| | TD 3669 | |
| | 5" @ 3667' | |
| 12/8 | " | |
| 12/15 | 500 acid CO | |
| 12/22 | " | |
| 12/29 | " | |
| 1/5 | 500 acid | |
| | TD 3671' | |
| 1/12 | " | |
| 1/19 | " | |
| 1/26 | 1000 acid wtr squeeze | |
| 2/2 | " | |
| 2/9 | TD 3671' | |
| | Arb. 3666' | |
| | Aband, | |
| | ABANDONED | |

Map No. _____ Sec. 27 Twp. 12 R. 17W

Well No. 1 Schneidler

Brunson Drlg.

Company _____

FIRST REPORT

Contractor _____

NW/C

SECTION PLAT

| | | | |
|---|--|--|--|
| 0 | | | |
| | | | |
| | | | |
| | | | |
| | | | |

330 Ft. from N. Line

_____ Ft. from S. Line

_____ Ft. from E. Line

330 Ft. from W. Line

Ellis County

Location X

Rig up _____

Drilling and Remarks:

RECORD

Cased _____ in., _____ ft.

Sand _____

Gas _____

Oil _____

Total Depth _____

PRODUCTION

1st 24 hrs. Nat. _____

1st 24 hrs. after shot _____

Gas _____ Cu. Ft.

Dry Hole _____

Abandoned _____

Date

OCT 27 1948

19

S. J. LEWIS

Scout

Schmidler

Map No. K71 Sec. 27 Twp. 12 R. 19W

Well No. 1 Schmidler

Brunson Dig Company
ABANDONED

Contractor
NWC E. 2145
SECTION PLAT

330 Ft. from N. Line

_____ Ft. from S. Line

_____ Ft. from E. Line

330 Ft. from W. Line

| | | | |
|---|--|--|--|
| 0 | | | |
| | | | |
| | | | |
| | | | |
| | | | |

Ellis

Location _____

Rig up _____

Drilling and Remarks:

Case 3666

RECORD

Cased _____ in., _____ ft.

Sand _____

Gas _____

Oil _____

Total Depth 3671

PRODUCTION

1st 24 hrs. Nat. _____

1st 24 hrs. after shot _____

Gas _____ Cu. Ft.

Dry Hole _____

Abandoned _____

Date

FEB 9 1949 19

S. J. LEWIS Scout