

Ellis


KANSAS

DX 78-1

Section 27 Township 12 Range 17W

Well No. #1 Windholz

Company Brinrich

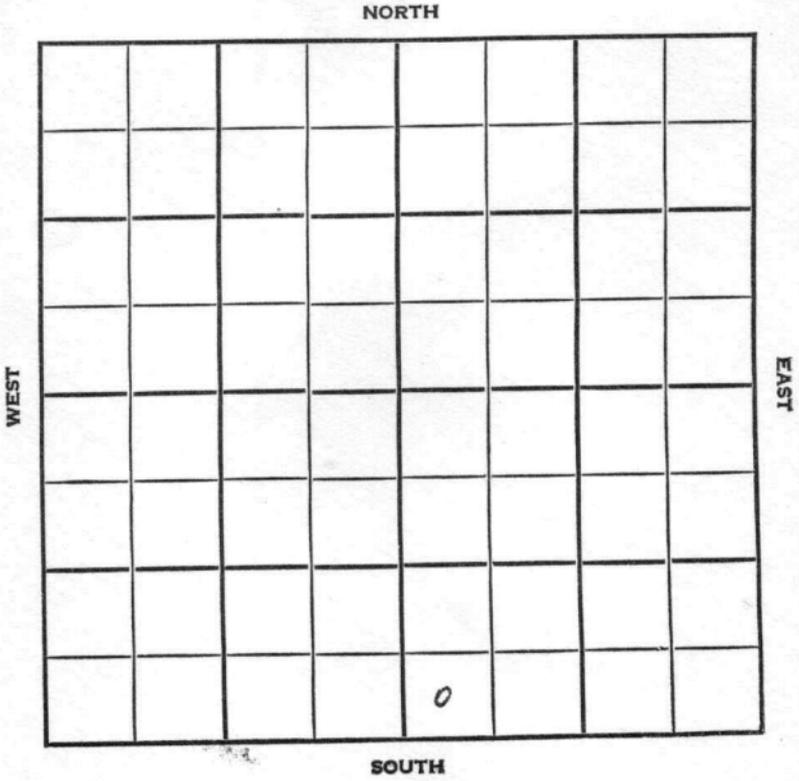

Ellis

KANSAS


SEC.	TWP.	R.
27	12	17W

WELL NO. #1 Windholz FARM

COMPANY Brinrich

CONTRACTOR Brunson

_____ Ft. from N. Line
 330 _____ Ft. from S. Line
 _____ Ft. from E. Line
 330 _____ Ft. from W. Line

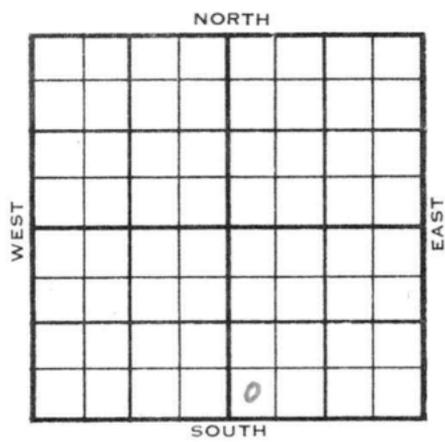

SW SW SE

	ELEVATION	REPORT
1955	2066'	

2/23
 3/2

Spud 2-17-55
 8" @ 191'
 Drlg. 3083'
 Spud 2-17-55
 D & A
 TD 3700'
 8" @ 191'
 Anhy 1270' Heeb. 3297' Tor. 3317'
 Lans 3342' Cong. 3600'
 TD 3700
 D & A

ABANDONED


County Ellis State Kansas

Sec. 27 (Blk. 12) (Sur. 17W) (Twp. 12) (Rge. 17W) Map No.

Operator Brinrich

Well No. 1 Farm Windholz

Elev. 2066 Location SW SW SE

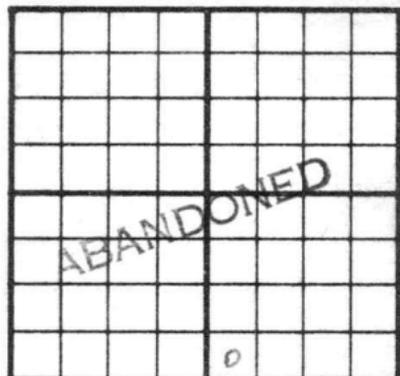

330 Ft. From S Line SE

330 Ft. From W Line Quarter

1st. Report

Completion MAR 2 1955

Remarks

Brunson Drlg. - Contr.

Spudding Date 2-17-55

Drlg. Data D & A TD 3700

8" @ 191 Anhy 1270 Heeb. 3297

Tor. 3317 Lans. 3342 Cong. 3600

TD 3700

D & A

FABEN GILSTRAP