


Section 20 Township 12 Range 17W

Well No. #1 Schmeidler

Company Duke & Wood

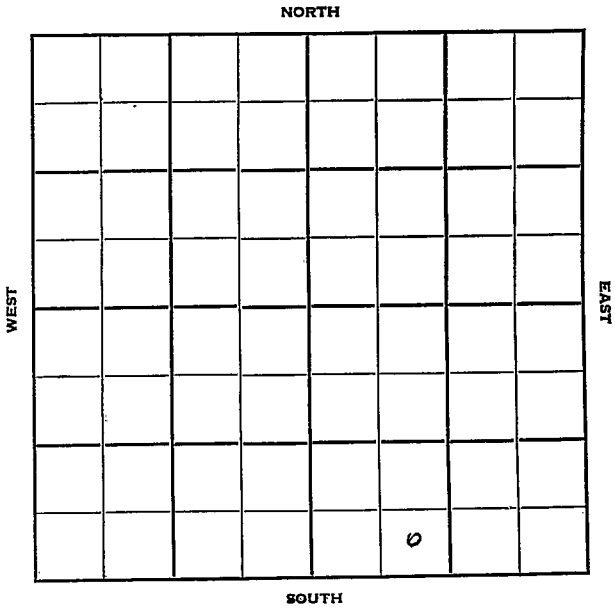

Sec. 20 Twp. 12 R. 17W

Well No. #1 Schmeidler Farm

Duke & Wood Company

Contractor


Ft. from N. Line

330' Ft. from S. Line

Ft. from E. Line

990' Ft. from W. Line

SE SW SE

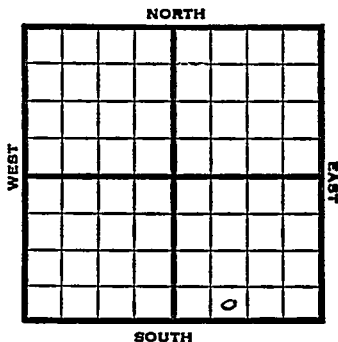

1951 Elev. 2090' REPORT

4/11 Location

5/23 Spud 4-3-51

Oil well TD 3634' 8" @ 145'

Anhy 1301' Heeb 3304' KC 3375'

DST 3389-3430 open 1 hr. rec 180' HOCM

Cong 3598' Arb. 3614-15'

5" @ 3614 TD 3634' 2000 A

S/4 BOPH SP 3456' 24/3418-22

12/3424-27 500 A 2000 A

S/ 4 BOPH

Comp. 60 BOPD

COMPLETED

