


KANSASSection 28 Township 12 Range 17WWell No. 1 SchmeidlerCompany Brunson Drlg.**Schmeidler**

NORTH

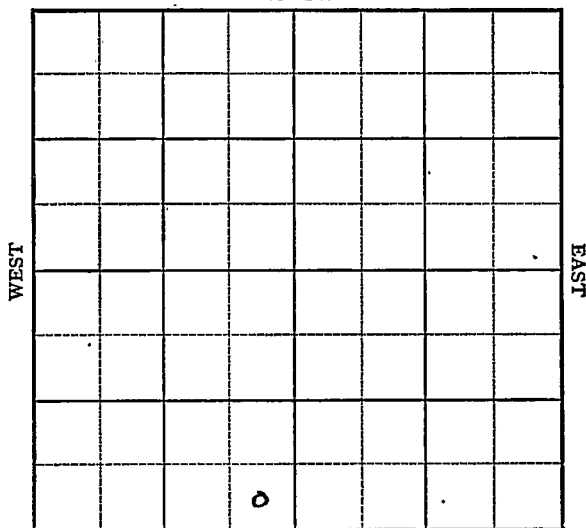

SOUTH

Ellis KANSAS

Sec. 28 Twp. 12 R. 17W ✓

Well No. #1 Schmeidler Farm

Brunson Drlg.


Schmeidler Pool (Brunson Drlg., Cont.) Company

990 Ft. from N. Line

~~330~~ Ft. from S. Line

330 Ft. from E. Line

Ft. from W. Line

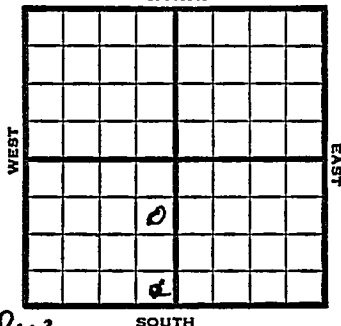

~~SE SW~~ 2 E NE SW

1949

Elev 2101'

REPORT

8/3

RUR

8/10

8" @ 1042'

Drlg 2660'

8/27

Drlg 3290'

8/24

TD 3672'

Lans 3396'

Cong 3670'

Aband.

ABANDONED

Kansas

Schmeidler

Map No. _____ Sec. 28 Twp. 12 R. 17W

Well No. 1 Schmeidler

Brunson Drlg. _____ Company

Brunson Drlg. _____ Contractor

SE SW

FIRST REPORT
SECTION PLAT


_____ Ft. from N. Line

330 Ft. from S. Line

330 Ft. from E. Line

_____ Ft. from W. Line

Ellis County

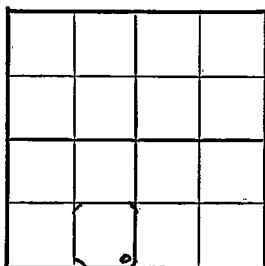

Location _____

Rig up _____

Drilling and Remarks:

ROR

RECORD

Cased _____ in., _____ ft.

Sand _____

Gas _____

Oil _____

Total Depth _____

PRODUCTION

1st 24 hrs. Nat. _____

1st 24 hrs. after shot _____

Gas _____ Cu. Ft.

Dry Hole _____

Abandoned _____

Date

AUG 3 1949 19

S. J. LEWIS

Scout

Kansas

Map No. 571 Sec. 28 Twp. 12 R. 17WWell No. 1 Schmeidler

Brunson Drlg. _____ Company

ABANDONED

Contractor


SE NE SW

E. 2101
SECTION PLAT990 Ft. from N. Line

_____ Ft. from S. Line

330 Ft. from E. Line

_____ Ft. from W. Line

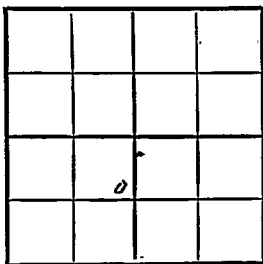

Ellis County

RECORD

Location _____

Cased _____ in., _____ ft.

Rig up _____

Sand _____

Drilling and Remarks:

Gas _____

Oil _____

Total Depth 3672**PRODUCTION**

1st 24 hrs. Nat. _____

1st 24 hrs. after shot _____

Gas _____ Cu. Ft.

Dry Hole _____

Abandoned _____

Date

AUG 24 1949 19S. J. LEWIS

Scout