


Section 28 Township 12 Range 17 W

Well No. # 2 Schmeidler

Company Duke & Wood

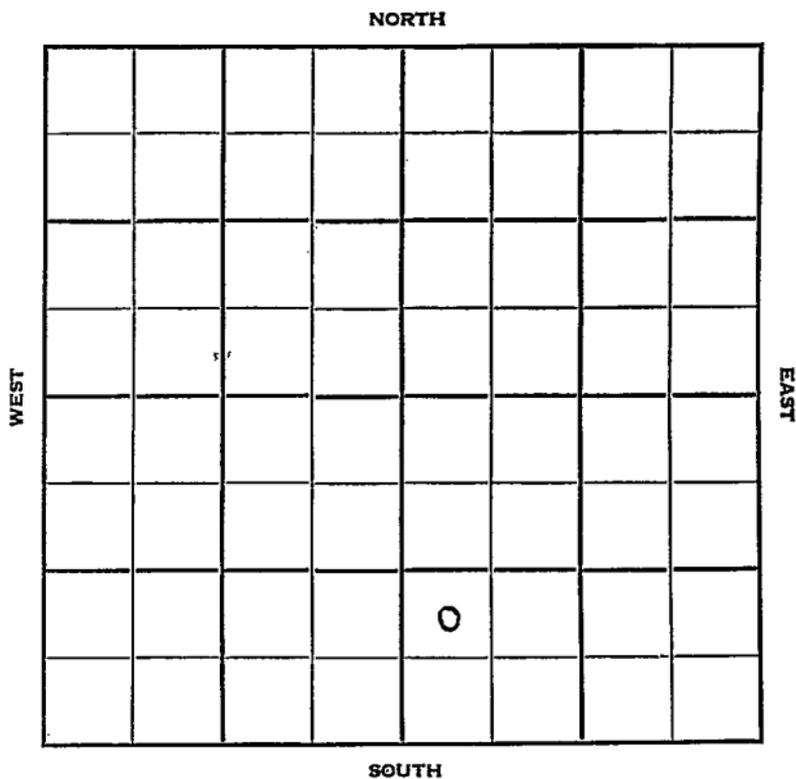

Ellis **KANSAS**

Sec. 28 Twp. 12 R. 17W

Well No. #2 Schmeidler Farm

Duke & Wood Company

Duke & Wood - Contr. Contractor

Schmeidler Pool


 Ft. from N. Line

990' Ft. from S. Line

 Ft. from E. Line

330' Ft. from W. Line

NW SW SE

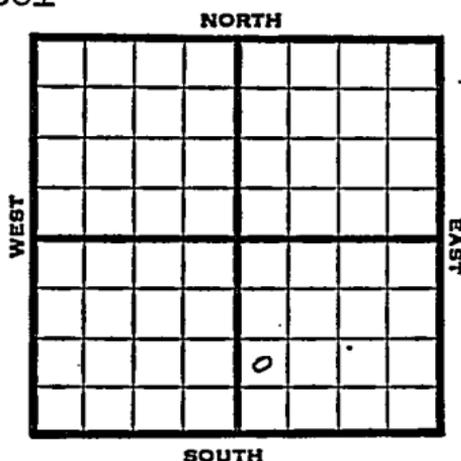

1951 Elev. 2090' REPORT

9/26 Spud 9-21-51
8" @ 145
Anhy 1335
Drlg. 1930'

10/10 Spud 9-21-51
D&A TD 3653
8" @ 145
Anhy 1335
Top 3048
Heeb. 3320
Br Lime 3340
Lans. 3366
Cong. 3615
Simp. 3644
TD 3653 D&A

ABANDONED

