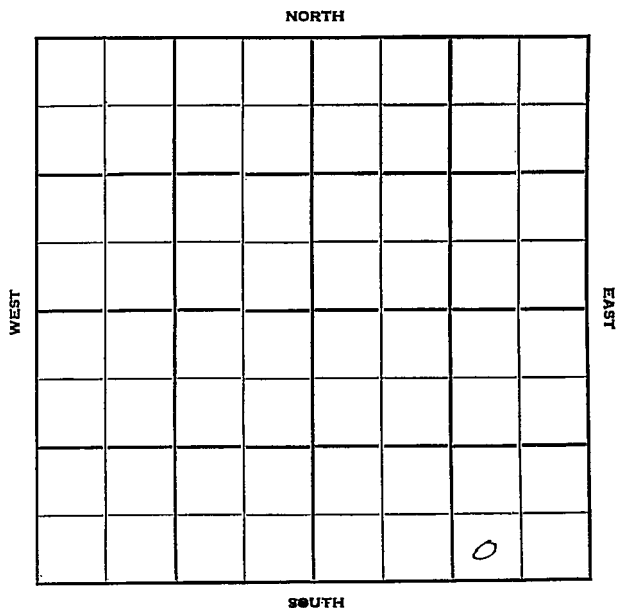


Section 28 Township 12 Range 17WWell No. #3 SchmeidlerCompany Bay Pet.

Ellis

KANSAS

Sec. 28 Twp. 12 R. 17W ✓

Well No. #3 Schmeidler Farm

Bay Pet. Company

Pickrell - Contr. Contractor


Schmeidler Pool

 Ft. from N. Line

330' Ft. from S. Line

990' Ft. from E. Line

 Ft. from W. Line

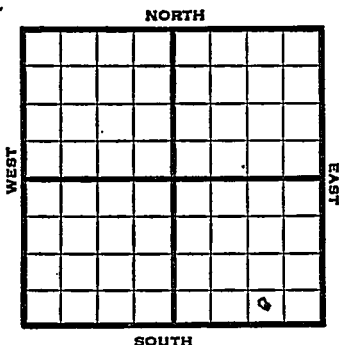

SW SE SE


1951 Elev. 2121' REPORT

6/13 Spud 6-10-51
8" @ 80'
Drlg. 815'

9/19 Spud 6-10-51
Oil well TD 3661' 8" @ 80
Heeb 3338' Lans. 3386'
DST 3410-56 open $\frac{1}{2}$ hr. rec 6' mud
DST 3537-78 open 1 hr. rec 8' mud
& SSO Arb. 3654-56' 5" @ 3655'
TD 3659' B/ $\frac{1}{2}$ bailer oil DD 3660'
500 A S/3 BOPH S/1 BOPH DD 3661'
1000 A no inc. S/3 BOPH
Comp. 23 BOPD

COMPLETED

J. E. TYRA

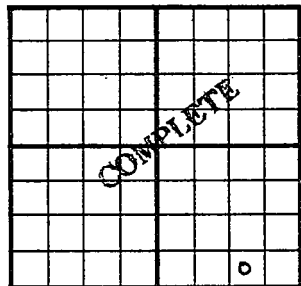County Ellis State KansasSec. 28 (Blk. 12) (Sur. 17W) Map No. Operator Bay Pet.Well No. 3 Farm SchmeidlerElev. 2121 Location SW SE SE330 Ft. From S Line SE990 Ft. From E Line Quarter1st. Report Completion SEP 19 1951Remarks Schmeidler PoolPickrell Drlg. - Contr.Spudding Date 6-10-51Drlg. Data Oil well TD 36618" @ 80 Heeb. 3338 Lans. 3386 DST3410-56 open $\frac{1}{2}$ hr. Rec. 6' mudDST 3537-78 open 1 hr. Rec. 8' mud & SSOArb. 3654-56 5" @ 3655 TD 3659B/ $\frac{1}{2}$ bailer oil DD 3660 500 AS/ 3 boph S/ 1 boph DD 3661 1000 Ano inc. S/ 3 boph Comp. 23 bopd

J. E. TYRA