


Section 28 Township 12 Range 17W

Well No. #1 Staab

Company Jones, Shelborne & Farmer

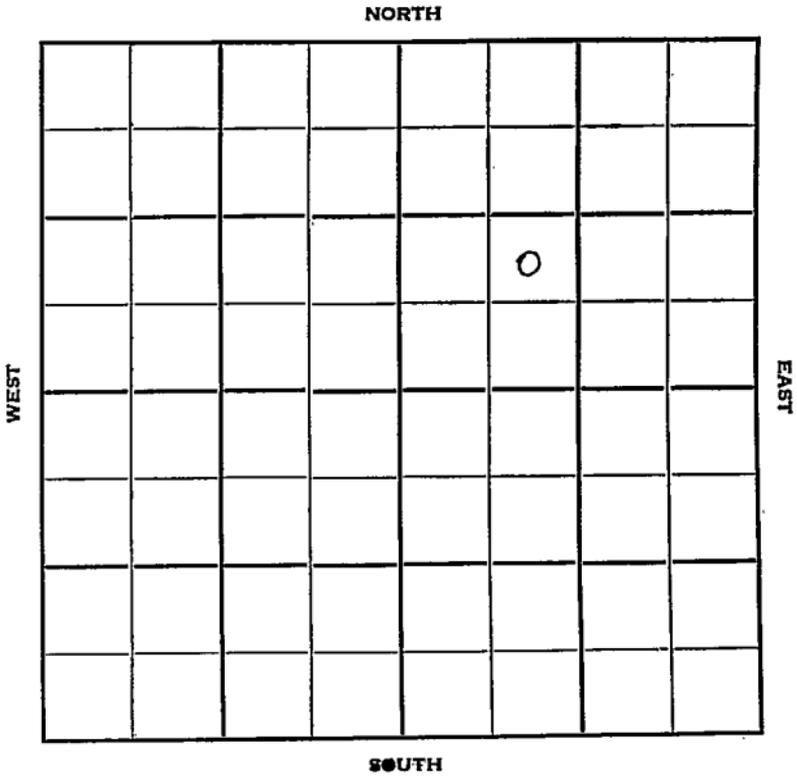

Ellis

KANSAS

Sec. 28 Twp. 12 R. 17 W ✓

Well No. # 1 Staab Farm

Nones, Shelborne & Farmer Company

Schmeidler Pool Contractor


Ft. from N. Line

990 Ft. from S. Line

Ft. from E. Line

990 Ft. from W. Line

NE SW NE

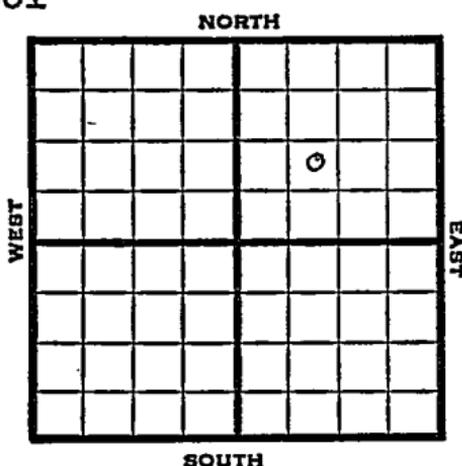

1951

Elev. 2139'

REPORT

5/16

Spud 5-12-51

8" @ 158'

Anhy 1355'

Drlg. 2055'

/6/27

Spud 5-12-51

Oil Well TD 3657

8" @ 158

Anhy 1355

Heeb. 3348

KC 3394

Simp 3651

Arb. 3656

5" @ 3657

1500 A

5 boph P/98 bopd Comp. 61 bopd

**COMPLETED**


County **Ellis** State **Kansas**

Sec. **28** (Blk.) **12** (Sur. Rge.) **17W** Map No.

Operator **Jones, Shelborne & Farmer**

Well No. **1** Farm **Staab**

Elev. Location **NE SW NE**

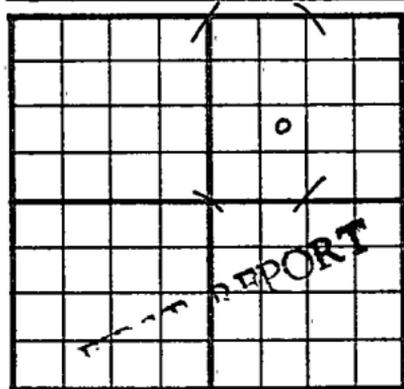

**990** Ft. From **S** Line **NE**

**990** Ft. From **W** Line **Quarter**

1st. Report **MAY 16 1951**

Completion

Remarks

Spudding Date **5-12-51**

Drlg. Data **Schmeidler Pool**

**8" @ 158 Any 1355 drlg. 2055**


County Ellis State Kansas

Sec. 28 (Blk. 12) (Sur. 17W) (Twp. 12) (Rge. 17W) Map No.

Operator Jones, Shelborne & Farmer

Well No. 1 Farm Staab

Elev. 2139 Location NE SW NE

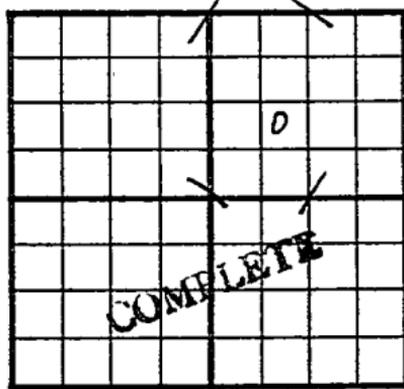

990 Ft. From S Line NE

990 Ft. From W Line Quarter

1st. Report

Completion JUN 27 1951

Remarks Schmeidler Pool

Spudding Date 5-12-51

Drilg. Data Oil well TD 3657

8" @ 158 Anhy 1355 Heeb. 3348

KC 3394 Simp. 3651 Arb. 3656

5" @ 3657 1500 A 5 boph P/ 98 bopd

Comp. 61 bopd

J. E. TYRA