


Section 28 Township 12 Range 17W

Well No. #2 Giebler

Company B & R Drlg. Co.

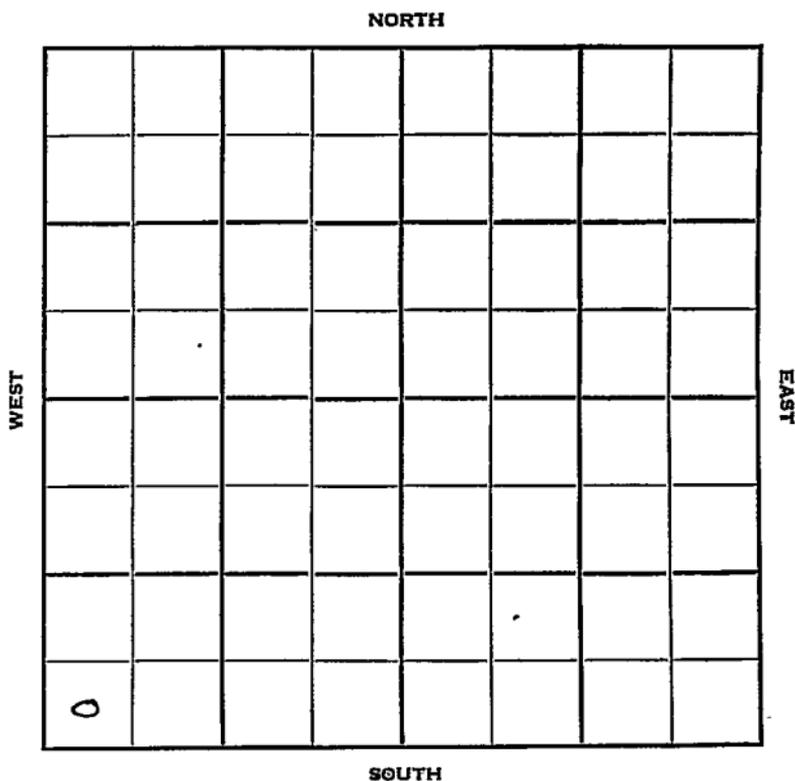

Sec. 28 Twp. 12 R. 17W

Well No. #2 Giebler Farm

B & R Drlg. Co. Company

B & R Drlg. Contractor  
Smidler


Ft. from N. Line

330 Ft. from S. Line

Ft. from E. Line

330 Ft. from W. Line

SW SW SW

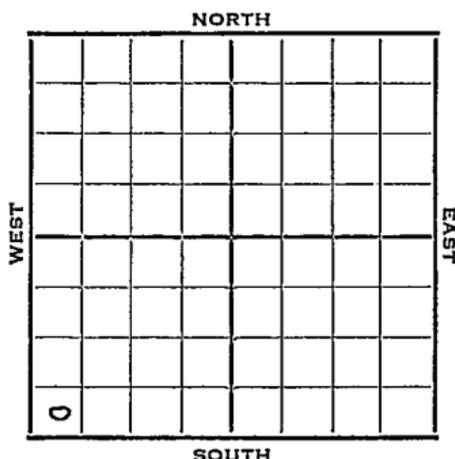

1952 Elev. 2141' REPORT

3/5 Spud 3-2-52  
Drlg. 150'

3/12 8" @ 224'  
Anhy 1365'  
Drlg. 2757'

3/19 KC 3411  
DST 3443-65 1 hr. 6 OCM 60' WCM 800#  
Cong. 3670  
DST 3670-3700 TD 1 hr. 30' M 820#  
Shut down orders

3/26 Spud 3-2-52  
D&A TD 3720 8" @ 224'  
Anhy 1365 KC 3411  
DST 3433-65 open 1 hr. rec. 6' OCM  
60' WCM Cong. 3670  
DST 3670-3700 open 1 hr. rec. 30'  
mud Arb. 3713 TD 3720  
D&A

**ABANDONED**



