


KANSAS

Ellis

Section 28 Township 12 Range 17W

Well No. 2 Schmiedler

Company Brunson Drlg.

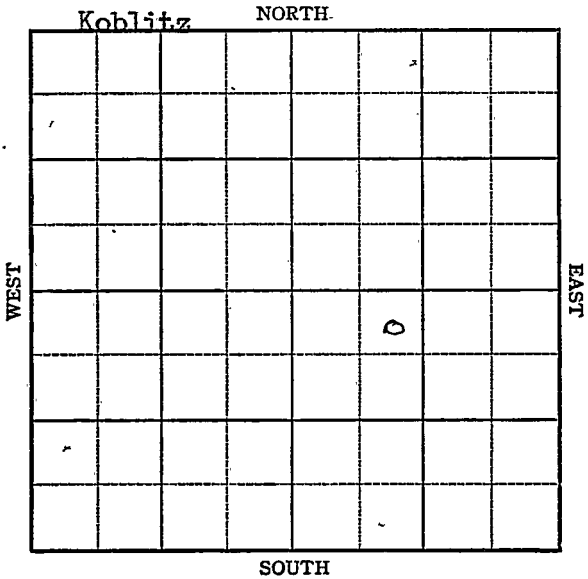


KANSAS

Sec. 28 Twp. 12 R. 17-W

Well No. #2 Schmiedler Farm
Brunson Drlg. Company

330 Ft. from N. Line
 Ft. from S. Line
 Ft. from E. Line
990 Ft. from W. Line

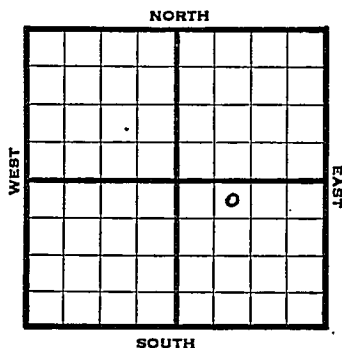

NE NW SE

1947

Elev. 2118

REPORT

4/9

Anhy. 1332
Drlg. 2140'

4/15

8" @ 217'
Lansing 3400'
TD 3590'
Lost Circulation

4/23

Cong 3646
3674 in Cong
TD 3674'

ABANDONED

KANSAS
Kansas

Koblitz Pool

Map No. K71 Sec. 28 Twp. 12 R. 17WWell No. 2 SchmiedlerBrunson Drlg.

Company

first REPORT

Contractor

NE NW SE

SECTION PLAT

330 Ft. from N. Line Ft. from S. Line Ft. from E. Line990 Ft. from W. Line

		o	

Ellis County

Location Rig up

Drilling and Remarks:

Anhy 1332

drlg. 2140

RECORD

Cased in, ft.Sand Gas Oil Total Depth

PRODUCTION

1st 24 hrs. Nat. 1st 24 hrs. after shot Gas Cu. Ft.Dry Hole Abandoned

Date

APR 9 1947 19 S. J. LEWIS Scout

Kansas

Map No. 71 Sec. 28 Twp. 12 R. 17WWell No. 2 SchmiédlerBrunson Drlg. Company**ABANDONED**

Contractor

NE NW SE

*E1.2118***SECTION PLAT**330 Ft. from N. Line Ft. from S. Line Ft. from E. Line990 Ft. from W. Line

		0	

Ellis CountyLocation Rig up

Drilling and Remarks:

*Cong 8646**8674 in Cong***RECORD**Cased in, ft.Sand Gas Oil Total Depth 8674**PRODUCTION**1st 24 hrs. Nat. 1st 24 hrs. after shot Gas Cu. Ft.Dry Hole Abandoned

Date

APR 23 194719S. J. LEWISScout