


Section 28 Township 12 Range 17-W

Well No. #1 Stabb

Company W E Wickizer

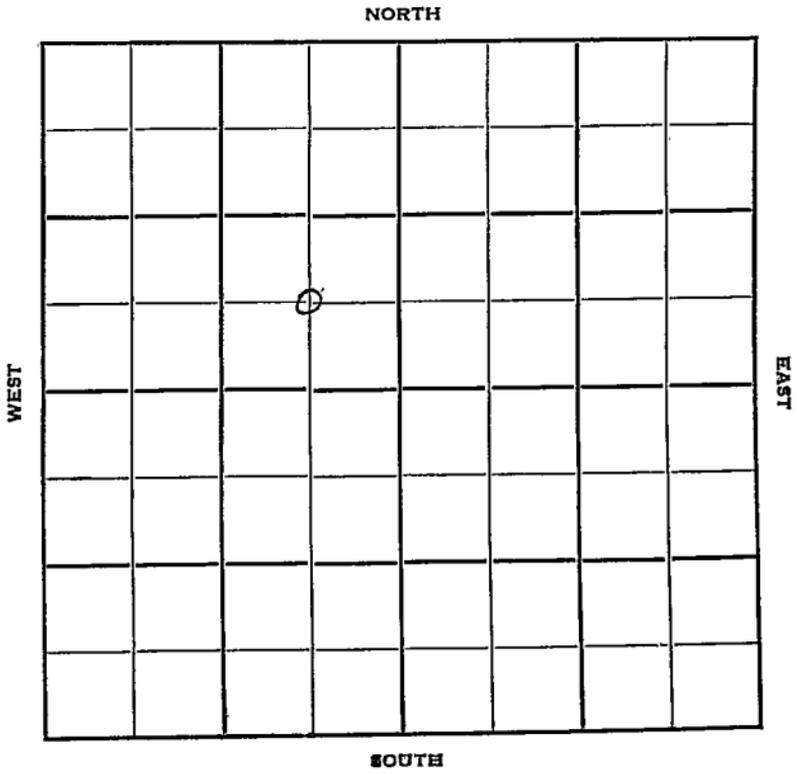


Sec. 28 Twp. _____ R. _____

Well No. #1 Staab Farm _____

W. E. Wickizer Company _____

Schmeidler Pool Contractor _____

_____ Ft. from N. Line
660' Ft. from S. Line
660' Ft. from E. Line
_____ Ft. from W. Line

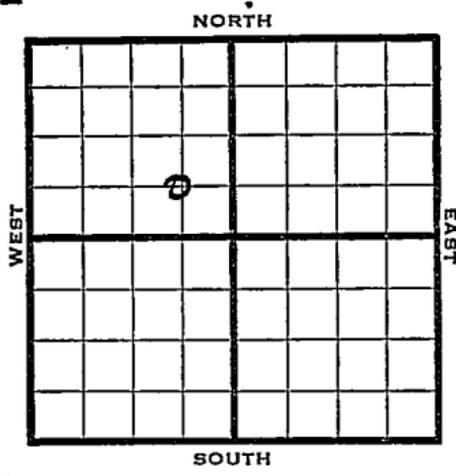

C SE NW

1950 **Elev 2117 REPORT**

8/23 Spud 8-9-50
8-5/8" @ 208'
Anhy 1335-74
Heeb 3347'
Lans. 3415'
Drlg. 3600'

9/6 TD 3711
8 5/8" @ 208
Anhy 1335-74
Lans 3415
D&A

Heeb 3347
Arb 3682-3711 TD

ABANDONED

County Ellis State Kansas

Sec. 28 (Blk. 12 (Sur. 17W Map No. 12) (Twp.) (Rge.)

Operator W. E. Wickizer

Well No. 1 Farm Staab

Elev. 2117 Location C SE NW

ABANDONED									

660 Ft. From S Line NW

660 Ft. From E Line Quarter

Ist. Report

Completion SEP 6 1950

Remarks

Schmeidler Pool

Spudding Date 8-9-50

Drig. Data D & A TD 3711

8 5/8" @ 208 Anhy 1335-74 Heeb. 3347

Lans. 3415 Arb. 3682-3711 TD D & A

J. E. TYRA