

Section 28 Township 12 Range 10W

Well No. #2 Staab

Company Brunson Drlg.
Schmeidler Pool

NORTH

							0

WEST

EAST

SOUTH

Sec. 28 Twp. 12 R. 17W

Well No. #2 Staab Farm

Brunson Drlg. Company


Schmeidler Pool

_____ Ft. from N. Line

330' Ft. from S. Line

330' Ft. from E. Line

_____ Ft. from W. Line

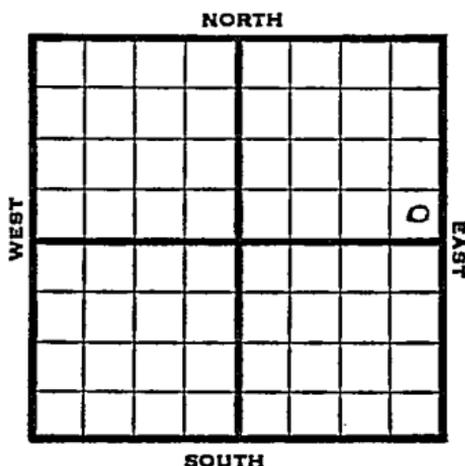

SE NE

1948

Ele. 2136'

REPORT

- 4/21 RUR
- 4/28 8" @ 996'
Drlg. 1860'
- 5/5 3540' fishing.
- 5/12 Arbuckle 3645'
TD 3651'
5" @ 3650'
RUST
- 5/19 500 Acid 150' oil 16 hrs.
TD 3661' -1500 acid
- 5/26 Swb 10 bbls oil PH
- 6/1 "
- 6/9 "
- 6/16 TD 3661'
Arb. 3645'
5" @ 3650' 1500 acid
Bump 50 Oil Pot
270 Gr.
Comp.

COMPLETED

Map No. _____ Sec. 28 Twp. 12 R. 17W

Well No. 2 Staab

_____ Brunson Drlg. _____ Company

FIRST REPORT

_____ Contractor

SE NE

SECTION PLAT

_____ Ft. from N. Line

330 Ft. from S. Line

330 Ft. from E. Line

_____ Ft. from W. Line

			o

Ellis County

Location _____

Rig up _____

Drilling and Remarks:

R U R

RECORD

Cased _____ in., _____ ft.

Sand _____

Gas _____

Oil _____

Total Depth _____

PRODUCTION

1st 24 hrs. Nat. _____

1st 24 hrs. after shot _____

Gas _____ Cu. Ft.

Dry Hole _____

Abandoned _____

Date

APR 21 1948

19

S. J. LEWIS

Scout

