

Sec. 28 Twp. 12 R.

Well No. #3 Staab Farm

Brunson Drlg.

Company

Schmeidler (Brunson Drlg., Cont.)

Pool


1150' Ft. from N. Line

Ft. from S. Line

330' Ft. from E. Line

Ft. from W. Line

SE NE NE

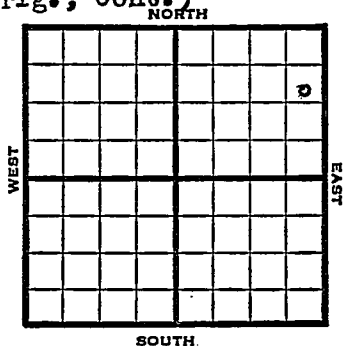

1949

Elev 2143' REPORT

6/22

8" @ 1015'
Anhy 1346'
Drlg. 2250'

6/28

Drlg 3660'

7/6

"

7/12

No report

7/20

Arb. 3670'
5" @ 3671
TD 3686'

8/27

TD 3699'
30 qts CO

8/3

SSO

8/10

"

8/17

Pipe Collapsed

8/24

"

8/31

"

9/7

"

9/14

"

9/21

"

9/28

"

10/5

"

10/12

TD 3699'
Arb. 3670'
5 @ 3671'
Pump 25 Oil Pot
270 Gr.
Comp

COMPLETED

Map No. _____ Sec. 28 Twp. 12 R. 17W

Well No. 3 Staab

_____ Brunson Drlg. _____ Company

_____ Brunson _____ Contractor

SE NE NE

FIRST REPORT
SECTION PLAT

1150 Ft. from N. Line

_____ Ft. from S. Line

330 Ft. from E. Line

_____ Ft. from W. Line

			o

Ellis County

Location _____

Rig up _____

Drilling and Remarks:

8" @ 1015 .

Anhy 1346

drlg. 2250

RECORD

Cased _____ in., _____ ft.

Sand _____

Gas _____

Oil _____

Total Depth _____

PRODUCTION

1st 24 hrs. Nat. _____

1st 24 hrs. after shot _____

Gas _____ Cu: Ft.

Dry Hole _____

Abandoned _____

Date

JUN 22 1949

19

S. J. LEWIS

Scout

Map No. _____ Sec. 28 Twp. 12 R. 17W

Well No. 3 Staab

Brunson Drlg. Company

COMPLETE

Contractor

SE NE NE

E12148
SECTION PLAT

1150 Ft. from N. Line

_____ Ft. from S. Line

330 Ft. from E. Line

_____ Ft. from W. Line

Ellis County

Location _____

Rig up _____

Drilling and Remarks:

Per # 3670

5" @ 3671

Pump 25 oil

27 2/3

RECORD

Cased _____ in., _____ ft.

Sand _____

Gas _____

Oil _____

Total Depth 3699

PRODUCTION

1st 24 hrs. Nat. _____

1st 24 hrs. after shot _____

Gas _____ Cu. Ft.

Dry Hole _____

Abandoned _____

Date

OCT 12 1949 19

S. J. LEWIS Scout