


Section 28 Township 12 Range 17W

Well No. #2 Staab "A"

Company Jones, Shelburne & Farmer

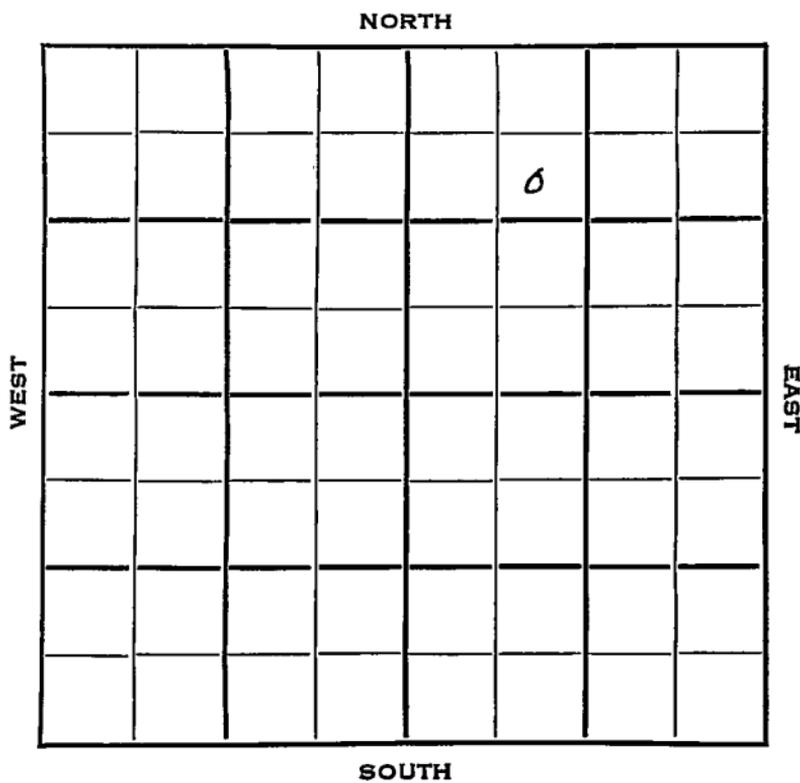

Sec. 28 Twp. 12 R. 17 W

Well No. # 2 Staab "A" Farm

Jones, Shelburne & Farmer Company

J-S-F Contractor


990 Ft. from N. Line

_____ Ft. from S. Line

_____ Ft. from E. Line

990 Ft. from W. Line

SE NW NE

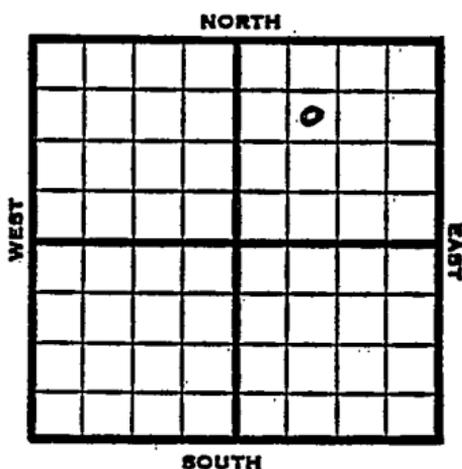

1953	Elev. 2138 REPORT
2/4	Spud 2-1-53 8" @ 165 Drlg. 1440'
2/12	Heeb 3338' Tor 3360' Lans 3385' DST 3414-26, 1/2 hr, 60' HOCM, 840' free oil, 90' SW
2/19	DST 3427-41, 1 hr, 150' hly OCM 940#. Arb 3643' TD 3650' 5" @ 3644
2/25	Spud 2-1-53 Oil well TD 3650 8" @ 165 Heeb 3338 Tor. 3360 Lans 3385 DST 3414-26 open 1/2 hr. rec 60' HOCM 840' free oil 90' SW DST 3427-41 open 1 hr. rec 150' HOCM 940# Arb. 3643 TD 3650 5" @ 3644 CO to 3650 FU 500' fluid 15 min FU 2100' oil 5 hr. S/12 BOPH 3 hr. Comp. 75 BOPD
COMPLETED	

