


Section 28 Township 12 Range 17 W

Well No. # 4 Staab "C"

Company Jones, Shelburne & Farmer

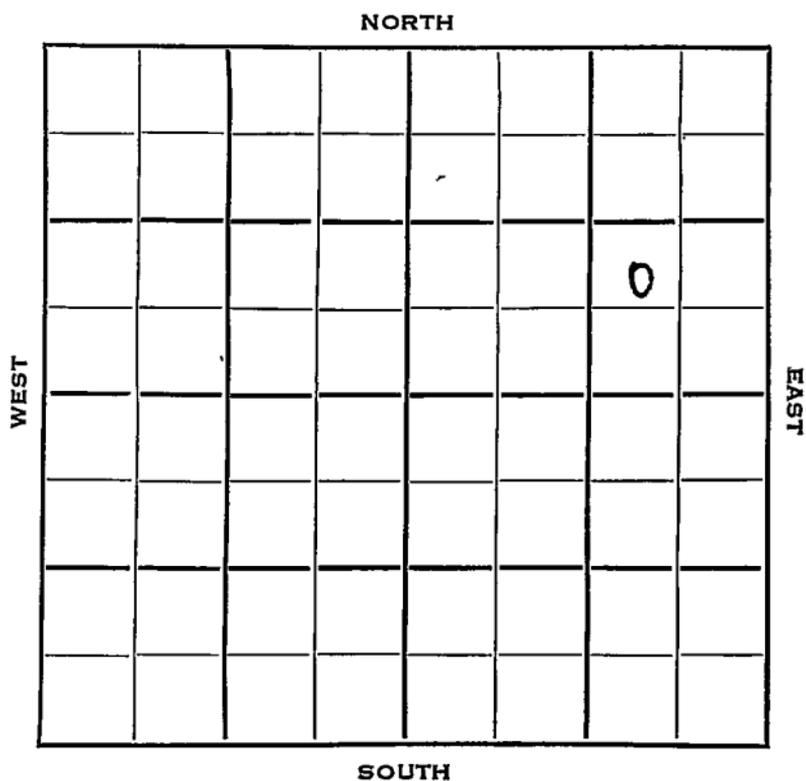

Ellis

KANSAS

Sec. 28 Twp. 12 R. 17W

Well No. #4 Staab "C" Farm

Jones, Shelburne & Farmer Company

Schmeidler Pool Contractor


Ft. from N. Line

990 Ft. from S. Line

990 Ft. from E. Line

Ft. from W. Line

NW SE NE

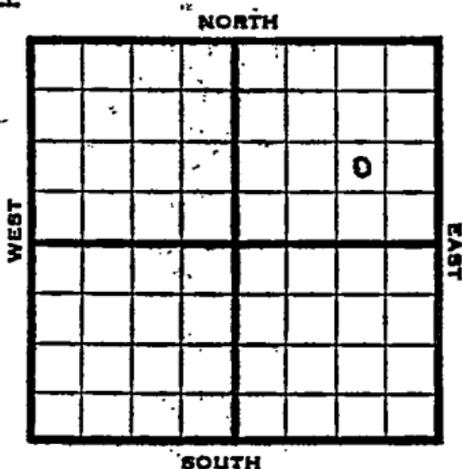

1953

Elev. 2142' REPORT

5/13

Spud 5-9-53  
8" @ 152  
Anhy 1340  
Drlg. 2295'

5/20

Spud 5-9-53 D & A TD 3700  
8" @ 152 Anhy 1340 Heeb 3349'  
Tor. 3370 Lans 3393 Cong 3656  
TD 3700 D & A

**ABANDONED**



