


Section 29 Township 12 Range 17W

Well No. #2 Schmidt

Company Dizdar Inv. & Nye

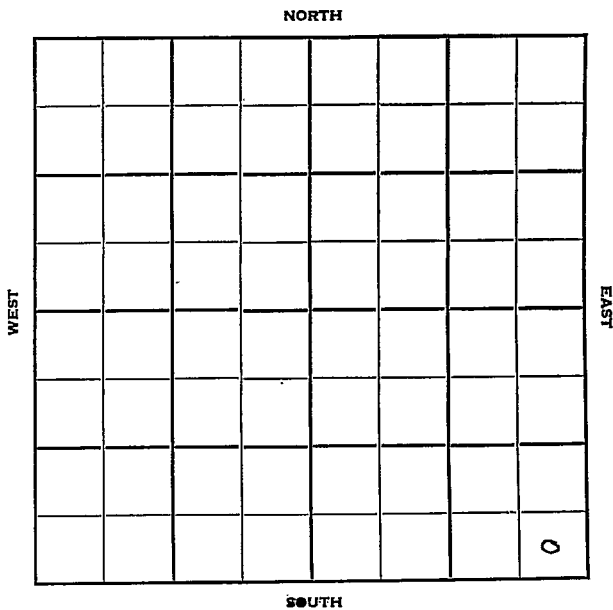

Sec. 29 Twp. 12 R. 17 W

Well No. # 2 Schmidt Farm

Dizard Inv & Nye Company

Nye Contractor


_____ Ft. from N. Line

330 Ft. from S. Line

330 Ft. from E. Line

_____ Ft. from W. Line

SE SE SE

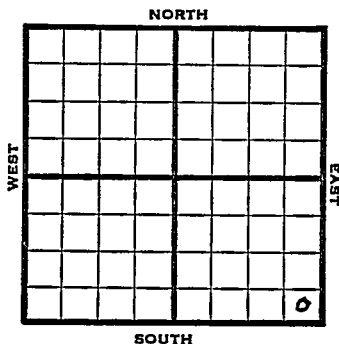

1952 Elev. 2145' REPORT

1/16 Spud 1-10-52
8" @ 90'
Anhy 1363'
Drlg. 2790'

2/6 Heeb. 3368 Lans 3412
Simp. 3668 Arb. 3684
TD 3689 5" @ 3684 POP

2/13 No report

2/20 "

2/27 Spud 1-10-52
Oil Well Td 3694
8" @ 90'
Anhy 1363 Heeb. 3368
Lans. 3412 Simp. 3668
Arb. 3684
TD 3689' 5" @ 3684 DD 3694
S/ 5 boph 500 A FU 2500' oil
S/ 10 boph Comp. 150 bopd

COMPLETED

