


Section 29 Township _____ Range 17W

Well No. #2 Schmidt

Company Glenn Nye

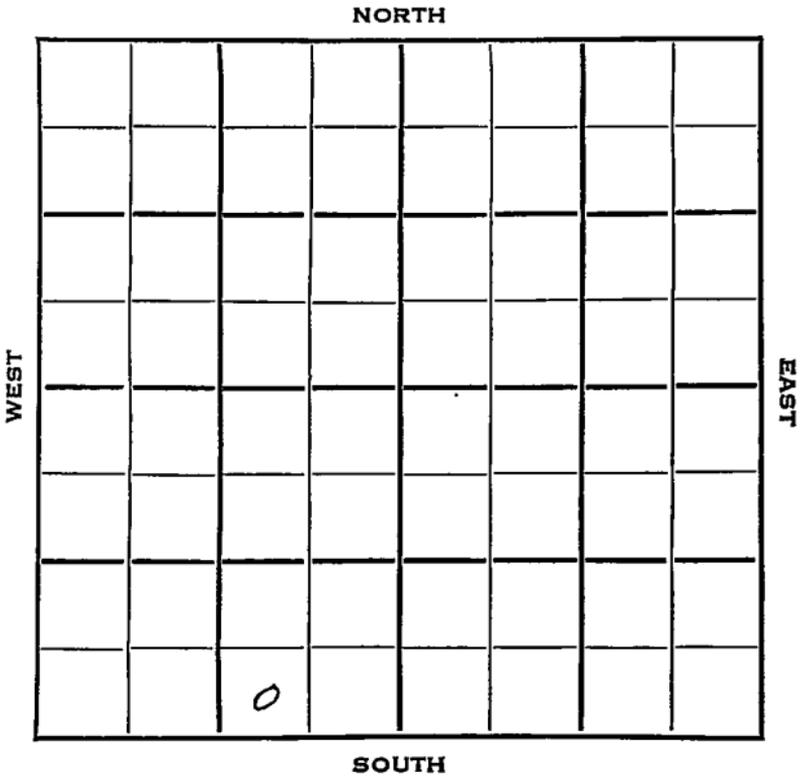

Sec. 29 Twp. 12 R. 17W

Well No. #2 Schmidt Farm _____

Glenn Nye Company _____

Nye - Contr. Contractor _____


_____ Ft. from N. Line

330 Ft. from S. Line

990 Ft. from E. Line

_____ Ft. from W. Line

SW SE SW

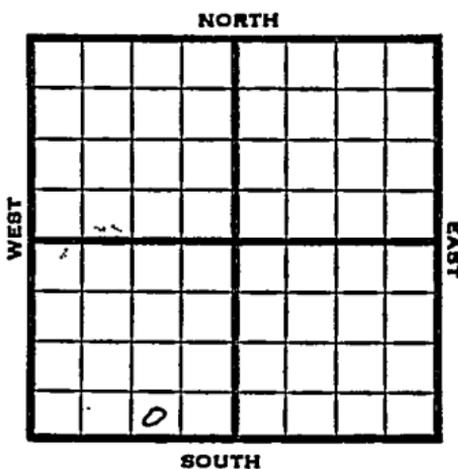

1953

Elev. 2104'

REPORT

3/4

Location

3/12

"

3/19

"

3/26

"

4/2

"

4/9

"

4/16

"

4/23

"

4/30

8" @ 180

Drlg. 3158'

5/7

RTD 3664 5" @ 3660

5/20

Spud 4-21-53. Oil well TD 3669

8" @ 180 Anhy 1330 Heeb 3328

Tor. 3348 KC 3373

DST 3421-45 open 1 hr rec 85' 0 &

GCSW, 180' SW 550#

DST 3450-74 open 1 hr rec 480' 0 & GCW

300' water. Marm. 3606' Cong 3614'

Simp. sh. 3646' Simp. sd. 3655'

Arb. 3658' TD 3664 5" @ 3660

DD 3669 1000 A

Comp. 50 BOPD

COMPLETED

