


Section 29 Township 12 Range 17W

Well No. #3 Schmidt

Company Disdar

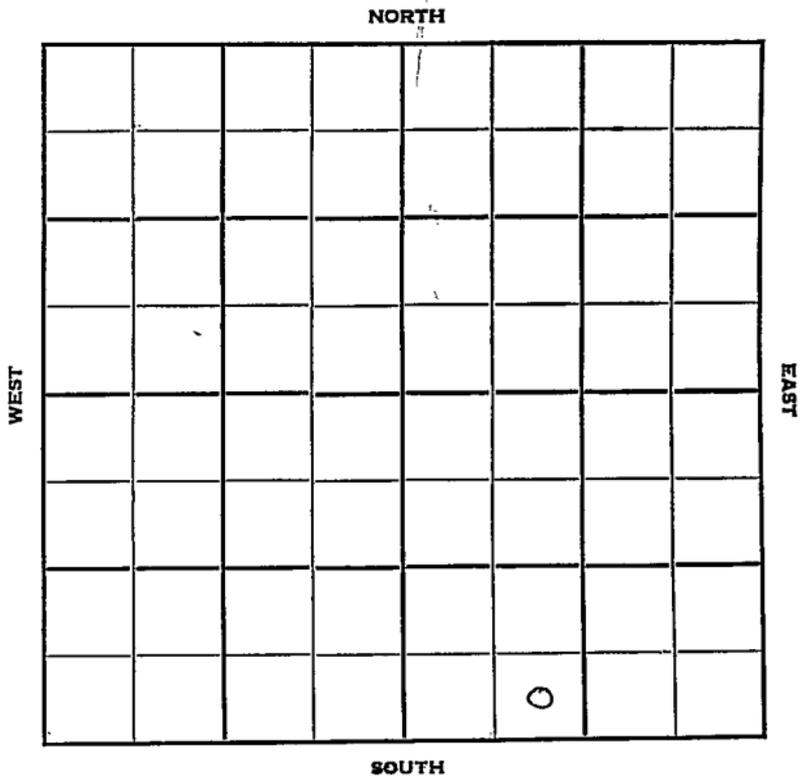

Ellis

KANSAS

Sec. 29 Twp. 12 R. 17W

Well No. #3 Schmidt Farm

Disdar Company

Contractor


Ft. from N. Line

330 Ft. from S. Line

Ft. from E. Line

990 Ft. from W. Line

SE SW SE

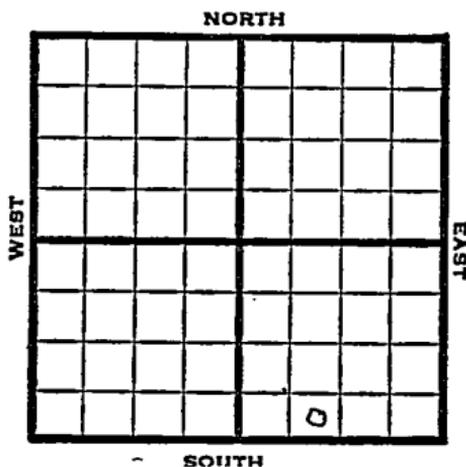

1952

Elev. 2132' REPORT

2/6

RUR

2/13

Anhy 1359

TD 2522'

2/20

Heeb 3366', Lans. 3409'

Drilg.-3588'

3/5

Arb. 3677'-80' RTD SO

5" @ 3680' WOC

3/12

WOCT

3/19

"

3/25

"

4/1

"

4/9

"

4/23

Spud 2-7-52 Oil Well TD 3685

8" @ 10' Anhy 1359 Heeb. 3366

Lans. 3409 Arb. 3677-80

5" @ 3679 CO to 3680 Test 3/4 boph

500 A DD 3685 S/ 3 boph 48 hr.

Comp. 50 bopd

COMPLETED

