


Section 29 Township 12 Range 17W

Well No. #3 Schmidt

Company Glen Nye

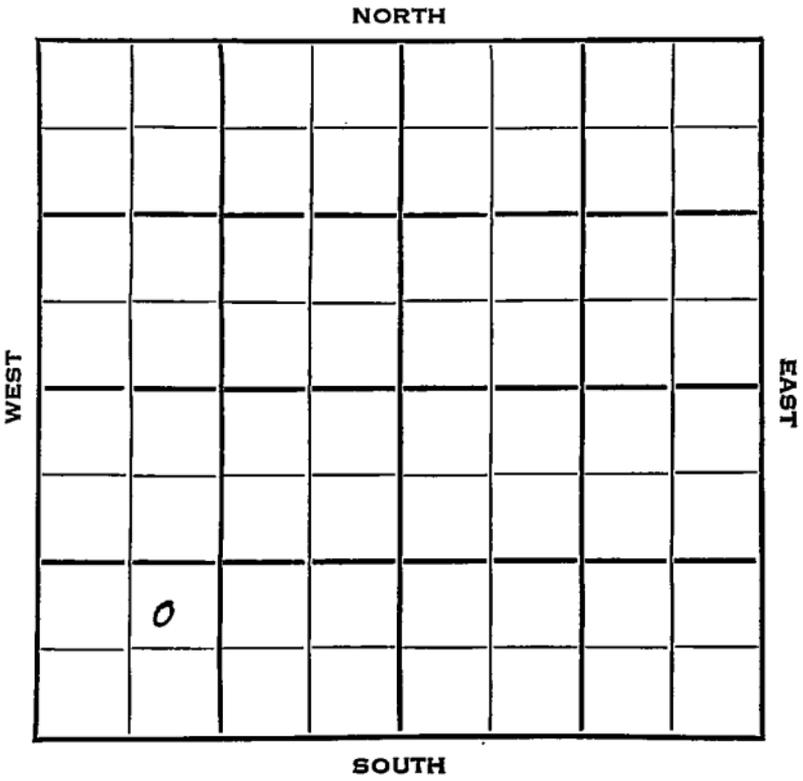

Ellis


KANSAS

SEC.	TWP.	R.
29	12	17W ✓

WELL NO. #3 Schmidt FARM

COMPANY Glen Nye

CONTRACTOR

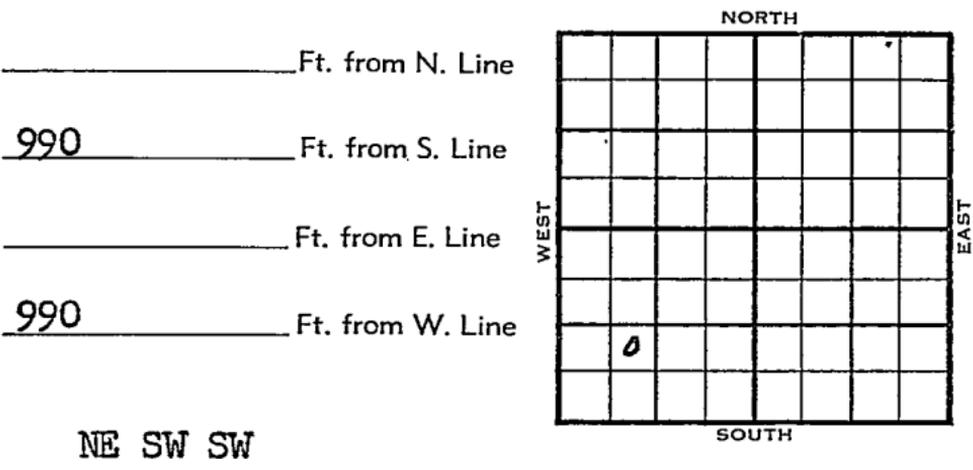

	ELEVATION	REPORT
1954	2119'	

4/7
4/14
5/19

Location
"
Spud 4-6-54 D & A TD 3690
8-5/8" @ 150 Anhy 1320 Heeb 3344
Tor. 3364 Lans 3387
DST 3554-72 open 20 min rec 200'
drlg. mud Off Cong. 3630
Arb. 3674 TD 3680 5" @ 3676
CO to 3680 DD 3690 19 GOPH 5 hr.
1000 A CO to 3687 sd-oil-frac.
S/3 BFPH mostly wtr. D & A

ABANDONED

