FORM 51 10M 2-49 PETROL


KANSAS Ellis

Section 29 Township 12 Range 17-W

Well No. #1 Staab

Company H H Blair

Wildcat

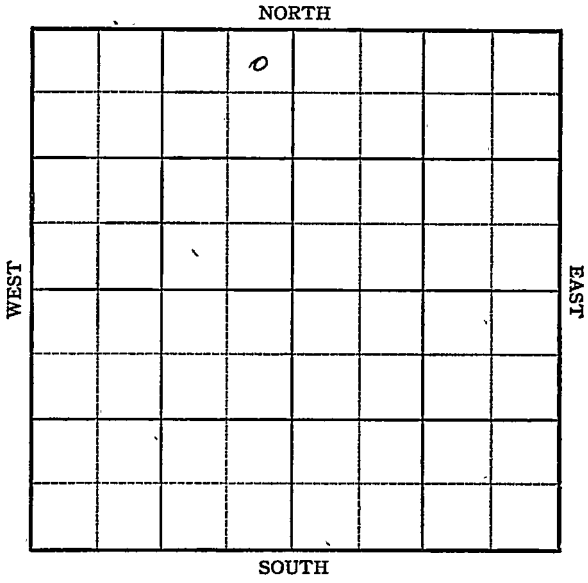

FORM 252-A
5M 10-48 PETROL

KANSAS

Ellis

Sec. 29 Twp. 12 R. 17W

Well No. #1 Staab Farm

H. H. Blair Company

Wildcat (Blair, Contr.)


330' Ft. from N. Line

Ft. from S. Line

330' Ft. from E. Line

Ft. from W. Line

NE NW

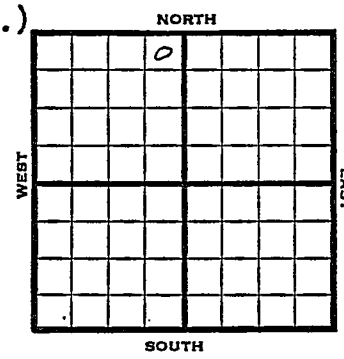

1949	Elev 2134' REPORT
11/16	10" @ 133' Drlg. 1300'
11/23	Drlg 3220'
11/30	TD 3786' Lansing 3415' Re Arb 3774' Aband.

ABANDONED

Form 26 200 Bks. 6-49 Petrol

Wildcat

Kansas

Map No. " Sec. 29 Twp. 12 R. 17W


Well No. 1 Staab

H. H. Blair Company

Blair Contractor

NE NW

FIRST REPORT
SECTION PLAT

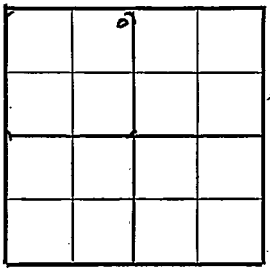

330 Ft. from N. Line

Ft. from S. Line

330 Ft. from E. Line

Ft. from W. Line

Ellis County

Location

Rig up

Drilling and Remarks:

10" @ 133
drlg. 1300

RECORD

Cased in., ft.

Sand

Gas

Oil

Total Depth

PRODUCTION

1st 24 hrs. Nat.

1st 24 hrs. after shot

Gas Cu. Ft.

Dry Hole

Abandoned

Date

NOV 16 1949 19

S. J. LEWIS Scout

Form 26 200 Bks. 6-49 Petrol

Wildcat

Kansas

Map No. _____ Sec. 29 Twp. 12 R. 17W

Well No. 1 Staab

H. H. Blair Company

ABANDONED Contractor

NE NW

330 Ft. from N. Line

_____ Ft. from S. Line


330 Ft. from E. Line

_____ Ft. from W. Line

Ellis County

E 1, 2 1/2 4

SECTION PLAT

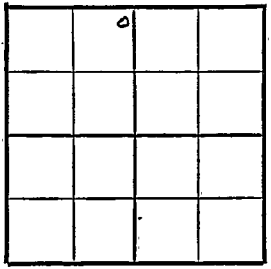

Location _____

Rig up _____

Drilling and Remarks:

Loma 3415-

Re Ql 3774

RECORD

Cased _____ in., _____ ft.

Sand _____

Gas _____

Oil _____

Total Depth 3786

PRODUCTION

1st 24 hrs. Nat. _____

1st 24 hrs. after shot _____

Gas _____ Cu. Ft.

Dry Hole _____

Abandoned _____

Date

NOV 30 1949 19

S. J. LEWIS Scout