


Section 29 Township 12 S Range 17 W

Well No. #1 Staab "A"

Company Michaelis Drlg. Co.

NORTH

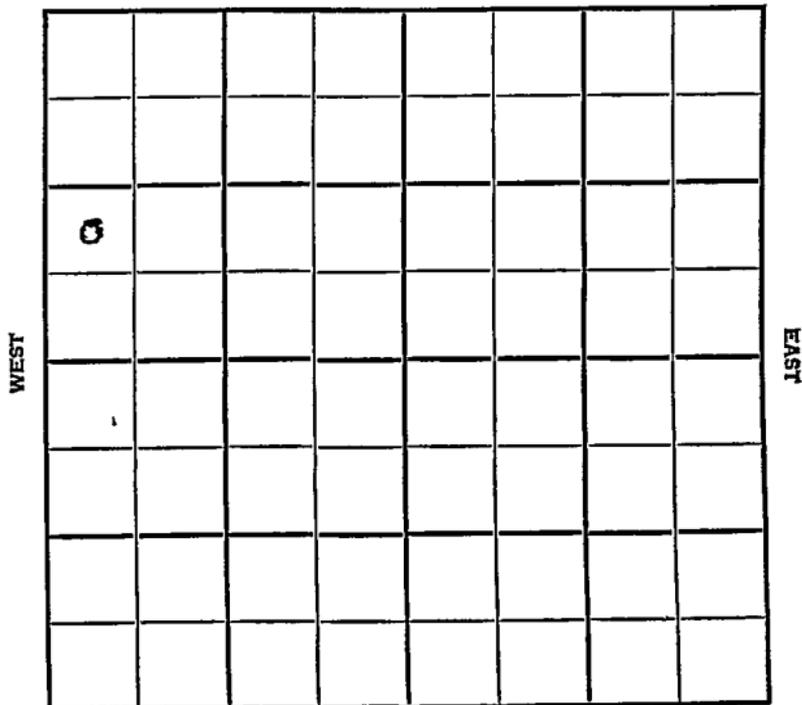

SOUTH

Ellis

KANSAS

SEC.	29	TWP.	12S	R.	17W
------	----	------	-----	----	-----

WELL NO. "1 Staab "A" FARM

COMPANY Michaelis Drlg Co.

CONTRACTOR Garvey
Wildcat


_____ Ft. from N. Line

_____ Ft. from S. Line

_____ Ft. from E. Line

_____ Ft. from W. Line

NW SW NW

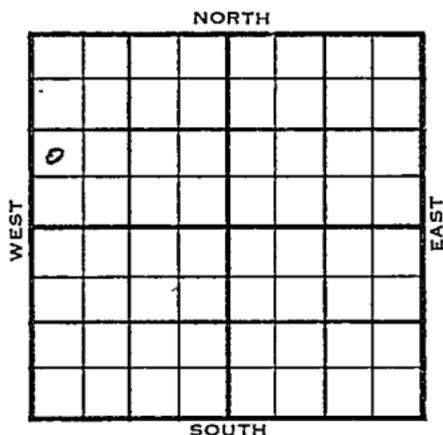

1955	ELEVATION	REPORT
	2133'	

9/28 MIRT

10/12 Comm 9-29-55
8 5/8" @ 209/150
 Anh 1368
 Tp 3105
 H 3367
 Tr 3390
 L 3419
 C 3661
 TD 3740
 DST 3501-26 open 1 hr Rec 40' somm
 575/20" D & A


ABANDONED

County **ELLIS** Elev. _____
 Sec. **29** Twp. **12** Rge. **17W**
 Company **Michaelis Drig. Co.**
 Farm Name **Staab "A"** No. **1**

TOPS	DEPTH	LOG	DATUM	Loc. in Sec.
Anh.				NW SW NW
Tp.				DS - NW/4
H.				
Tr.				
Dg.				
Bl.				
L.				Geol. _____
K.C.				Contr. Garvey
B.K.C.				feels tie #10
Ce.				
C.				
M.				Pool
M.				Wildcat
K.				
Mz.				
Mo.				
V.				
S.				
S.				
A.				
R.				
PE.				FIRST REPORT
G.				
T.D.				

Date Comm. **SEP 28 1955**


MIRT

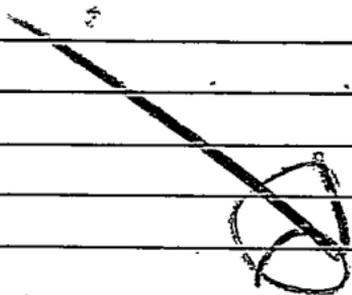

Co.
Lge.
No.
Sec.
T.
R.

County Ellis Elev. 2133
 Sec. 29 Twp. 12 Rge. 17W
 Company Michaelis Drilling
 Farm Name Staab "A" No. 1

TOPS //	DEPTH	LOG	DATUM
Anh.	1368		
Tp.	310.5		972
H.	3367		1234
Tr.	3390		1257
Dg.			
Bl.			
L.	3419		1286
K.C.			
B.K.C.			
Ce.			
C.	3661		1528
M.			
M.			
K.			
Mz.			
Ma.			
V.			
S.			
S.			
A.			
R.			
PE.			
G.			
T.D.	3740		

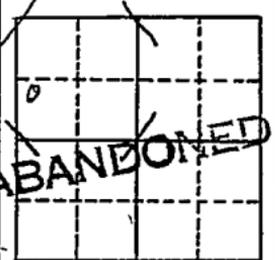Loc. in Sec. _____
 NW SW NW
 Geol. _____
 Contr. _____
 Garvey
 Pool
 Wildcat

 ABANDONED

Date Comm. 9-29-55 OCT 1 2 1955
8 5/8" @ 209/150 DST 3501-26 open 1 hr
Rec. 110' socm 575/20"
D & A

Co.
 Lse.
 No.
 Sec.
 T.
 R.