


Section 3 Township 12N Range 18W

Well No. #2 Thomas

Company Sohio & Derby Drlg.

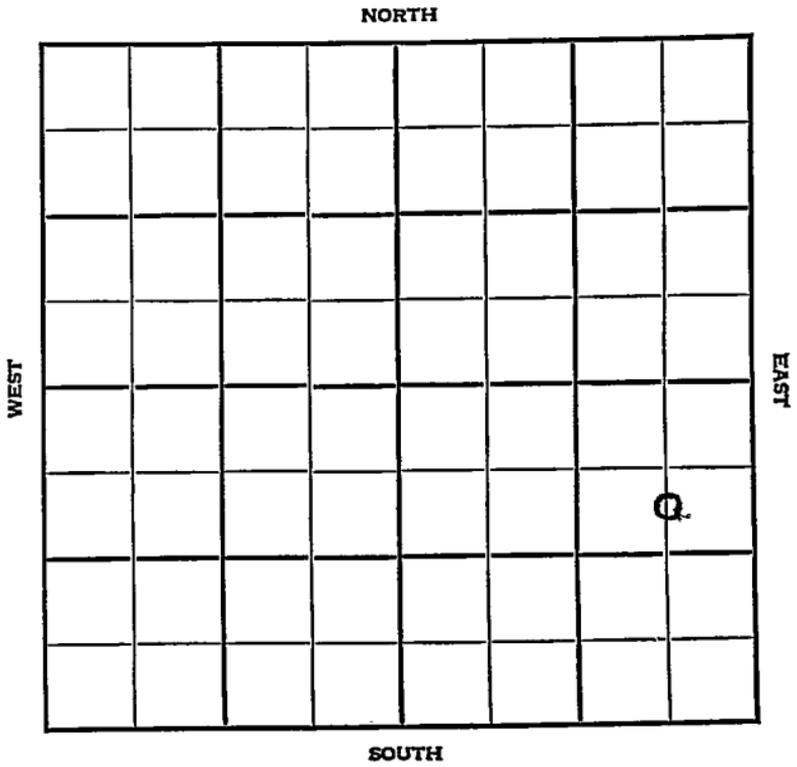

KANSAS

Ellis

Sec. 3 Twp. 12 R. 18W

Well No. #2 Thomas Farm

Sohio & Derby Drlg. Company

Stabb Pool


990' Ft. from N. Line

\_\_\_\_\_ Ft. from S. Line

660' Ft. from E. Line

\_\_\_\_\_ Ft. from W. Line

C S L NE SE

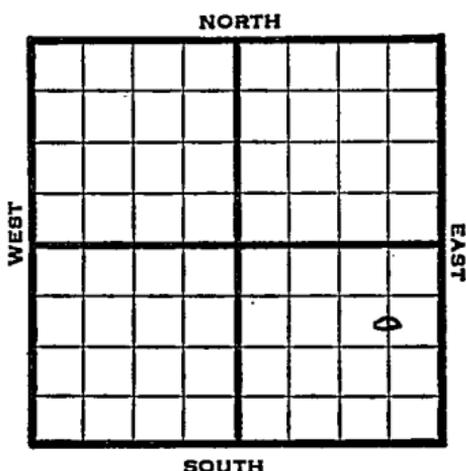

1948

Eli 2125'

REPORT

6/9 Drlg. 230'

6/16 8" @ 160'  
Drlg. 200'

6/23 Lansing 3370'  
Arbuckle 3645-48'  
TD 3648'  
5" @ 3646'  
RUST

6/29 TD 3650' - 1500 acid  
Bail 1 bbl oil & 1/2 bbl W PH 6 hrs.

8/8 " "

7/14 " "

7/21 TD 3650'  
Arb. 3645'  
5" @ 3646' 1500 Acid  
Pump 27 Oil / 65% Wtr Pot.  
28° Gr.  
Comp.

**COMPLETED**

Map No. \_\_\_\_\_ Sec. 3 Twp. 12 R. 18W

Well No. 2 Thomas

Sohio & Derby Drlg. Company

FIRST REPORT Contractor

C S L N E S E

SECTION PLAT

990 Ft. from N. Line

\_\_\_\_\_ Ft. from S. Line

660 Ft. from E. Line

\_\_\_\_\_ Ft. from W. Line

			6

Ellis County

Location \_\_\_\_\_

Rig up \_\_\_\_\_

Drilling and Remarks:

drlg. 230

RECORD

Cased \_\_\_\_\_ in., \_\_\_\_\_ ft.

Sand \_\_\_\_\_

Gas \_\_\_\_\_

Oil \_\_\_\_\_

Total Depth \_\_\_\_\_

PRODUCTION

1st 24 hrs. Nat. \_\_\_\_\_

1st 24 hrs. after shot \_\_\_\_\_

Gas \_\_\_\_\_ Cu. Ft.

Dry Hole \_\_\_\_\_

Abandoned \_\_\_\_\_

Date

JUN 9 1948 19\_\_\_\_

S. J. LEWIS Scout

Map No. 71 Sec. 3 Twp. 12 R. 18W

Well No. 2 Thomas

Sohio & Derby Drlg. Company

**COMPLETE**

Contractor

C S L NE SE

*E 1/2 2125*

SECTION PLAT

990 Ft. from N. Line

         Ft. from S. Line

660 Ft. from E. Line

         Ft. from W. Line

			o

Ellis County

RECORD

Location                                 

Cased          in.,          ft.

Rig up                                 

Sand                                 

Drilling and Remarks:

Gas                                 

Oil                                  ✓

Total Depth 3650

*Cr 3645*  
*5" @ 3646*  
*1500 ac/c*  
*Pump 27 oil + 65%*  
*Water P & Y*  
*280 lbs*

PRODUCTION

1st 24 hrs. Nat.                         

1st 24 hrs. after shot                         

Gas                                  Cu. Ft.

Dry Hole                                 

Abandoned                                 

Date

JUL 21 1948

19

S. J. LEWIS

Scout