


Ellis **KANSAS**

SECTION 3 TOWNSHIP 12 RANGE 18W

WELL NO. #2 Schumacher

COMPANY Osage Oil

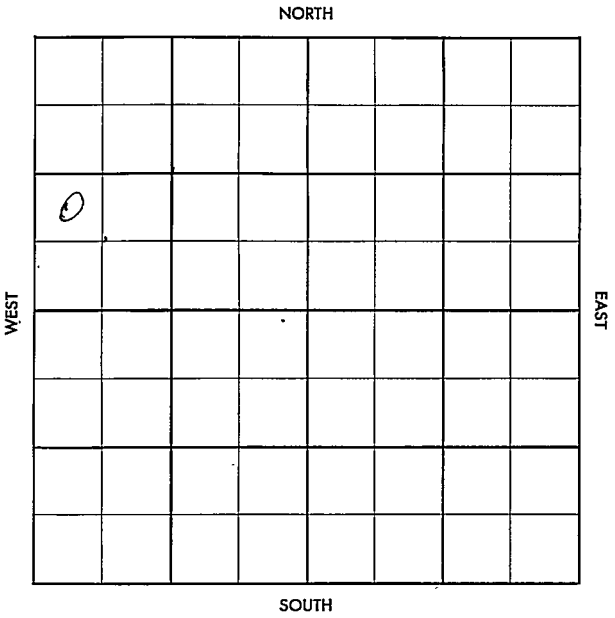

SEC. 3	TWP. 12	R. 18W
-----------	------------	-----------

WELL NO. #2 Schumacher FARM

COMPANY Osage Oil

CONTRACTOR Heathman

Walter


\_\_\_\_\_ Ft. from N. Line

\_\_\_\_\_ Ft. from S. Line

\_\_\_\_\_ Ft. from E. Line

\_\_\_\_\_ Ft. from W. Line

NW SW NW

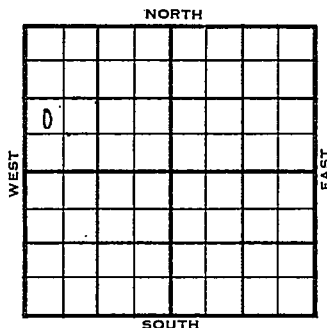

1956 ELEVATION 2201 DF, 2204 KB REPORT

3-28 Comm. 3-24-56  
8" @ 160 w/150  
Drlg. 2105'  
Anh. 1495

4-25 DST 3502-09 op 1/2 hr. rec. # 7' mud, 615#.  
DST 3509-41 op 1/2 hr. rec. 5' mud, 70#  
DST 3546-65 op 1/2 hr. rec. 5' mud, 630#  
DST 3630-45 op 40 min. rec. 5' mud, 60#  
DST 3672-3710 op 1/2 hr. rec. 10' rotary mud, 450/20"  
DST 3747-50 op 1/2 hr. rec. 10' rotary mud, 900#  
DST 3750-57 op 1 hr. rec. 15' mcho, 25' hvy black oil, 670/20"  
5 1/2" @ 3757/75  
GO to 3755, 28/ 3745-53, 10 gfph, mostly oil, 3 hrs., 250 A,  
S/ 4/10 boph, 4 hrs., 1000 A  
B/ 20 gfph, scum oil.  
D & A A. 3747 3744  
Tp. 3173 3173  
H. 3429 3430  
Tr. 3449 3450  
L. 3472 ## 3474  
BKC 3712  
C. 3724 TD 3758'

ABANDONED



2201 DF

2204 KB

County **Emis**

Elev.

Sec. **3** Twp. **12**

Rge.

18W

Company **Osage Oil**

Farm Name **Schumacher**

No. **2**

TOPS

DEPTH

LOG

DATUM

Loc. in Sec.

Anb. **1495**

NW SW NW

TP. **3173 3173**

H. **3429 3430**

Tr. **3449 3450**

Dg.

BL.

L. **3472 3474 1273**

Geol.

K.C.

B.K.C. **3712 1511**

Contr.

Ce.

C. **3724 1523**

Heathman

M.

M.

Pool

K.

Walter

Mz.

Me.

V.

S.

S.

A. **3747 3744 1543**

R.

PE.

G.

**ABANDONED**

T.D. **3758**

Date Comm. **3-24-56**

APR 25 1956

8" @ 160/150 DST 3 502-09 open 1/2 hr.

rec. 7' mud 615# DST 3509-41

open 1/2 hr. rec. 5' mud 70#

DST 3546-65 open 1/2 hr. rec. 5' mud

630# DST 3630-45 open 40 min.

rec. 5' mud 60# DST 3672-3710

open 1/2 hr. rec. 10' rotary mud 450/20"

DST 3747-50 open 1/2 hr. rec. 10' rotary

mu<sup>d</sup>

**OVER.**

900# DST 3750-57 open 1 hr. rec. 15'  
meho to 25' heavy black oil 670/20"  
5 1/2" @ 3757/75 C<sup>0</sup> to 3755 28/ 3745-53  
10 gph mostly oil 3 hr. 250 A  
S/ 4/10' boph 4 hr. 1000 A  
B/ 20 gph scum oil . . .

D & A

R. G.

MAY 4 1956