

**STATE CORPORATION COMMISSION OF KANSAS
OIL & GAS CONSERVATION DIVISION**

**WELL COMPLETION OR RECOMPLETION FORM
ACO-1 WELL HISTORY**

DESCRIPTION OF WELL AND LEASE

Operator: license # 5146
name Rains & Williamson Oil Co., Inc.
address 435 Page Court, 220 W. Douglas
Wichita, KS 67202
City/State/Zip

Operator Contact Person Juanita Green
Phone 265-9686

Contractor: license #
name Rains & Williamson Oil Co., Inc.

Wellsite Geologist
Phone

PURCHASER

Designate Type of Completion

☒ New Well ☐ Re-Entry ☐ Workover

☐ Oil ☐ SWD ☐ Temp Abd
☐ Gas ☐ Inj ☐ Delayed Comp.
☒ Other (Core, Water Supply etc.)

If OWWO: old well info as follows:

Operator
Well Name
Comp. Date Old Total Depth

WELL HISTORY

Drilling Method: ☒ Mud Rotary ☐ Air Rotary ☐ Cable

3-7-86 3-15-86 3-15-86
Spud Date Date Reached TD Completion Date

4550'
Total Depth PBTD

Amount of Surface Pipe Set and Cemented at 290' feet

Multiple Stage Cementing Collar Used? ☐ Yes ☐ No

If Yes, Show Depth Set feet

If alternate 2 completion, cement circulated
from feet depth to w/ SX cmt

API NO. 15- 063-21,015

County Gove
100' N & 100' E of SE SW SE
Sec. 29 Twp. 12S Rge. 30 X
(location)

430 Ft North from Southeast Corner of Sec
1550 Ft West from Southeast Corner of Sec
(Note: locate well in section plat below)


Lease Name Abell Well# 1

Field Name

Producing Formation

Elevation: Ground 2835 KB 2843

Section Plat

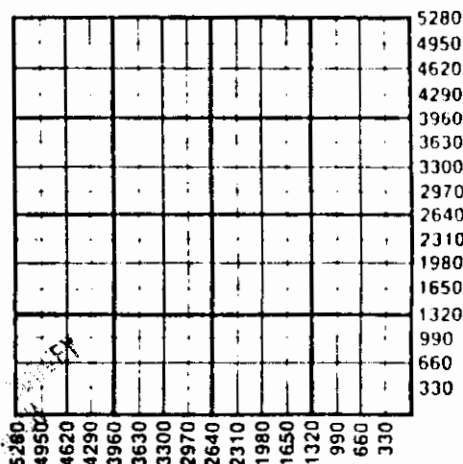

WATER SUPPLY INFORMATION

Source of Water:

Division of Water Resources Permit #

☐ Groundwater. Ft North From Southeast Corner
(Well) Ft. West From Southeast Corner
Sec Twp Rge ☐ East ☐ West

☐ Surface Water. Ft North From Southeast Corner
(Stream, Pond etc.) Ft West From Southeast Corner
Sec Twp Rge ☐ East ☐ West

☐ Other (explain)
(purchased from city, R.W.D.#)

Disposition of Produced Water: ☐ Disposal
☐ Repressuring

Docket #

INSTRUCTIONS: This form shall be completed in duplicate and filed with the Kansas Corporation Commission, 200 Colorado Derby Building, Wichita, Kansas 67202, within 90 days after completion or recompletion of any well. Rules 82-3-130 and 82-3-107 apply.

Information on side two of this form will be held confidential for a period of 12 months if requested in writing and submitted with the form. See rule 82-3-11 for confidentiality in excess of 12 months.