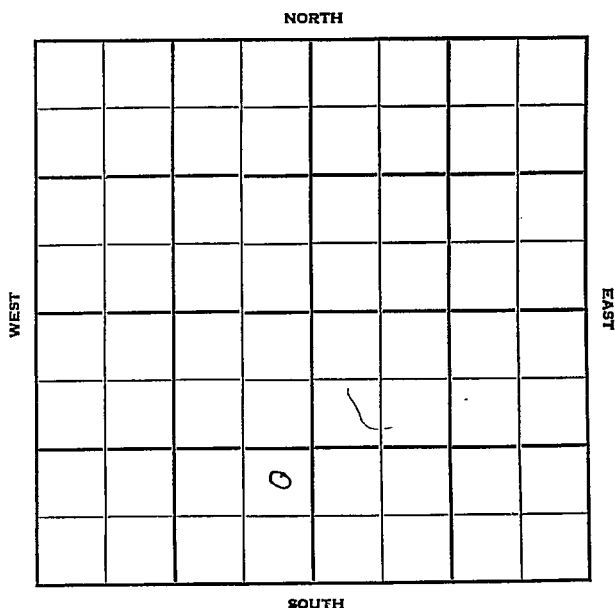


Section 30 Township 12 Range 17WWell No. #1 StaabCompany B&R Drlg.

Ellis KANSAS
12 17 W

Sec. 30 Twp. R. 17 W

Well No. # 1 Staab Farm

B & R Drlg. Company

Contractor

Wildcat

Ft. from N. Line


108C Ft. from S. Line

330 Ft. from E. Line

Ft. from W. Line

NE SE SW

CRA & Westgate - DHM

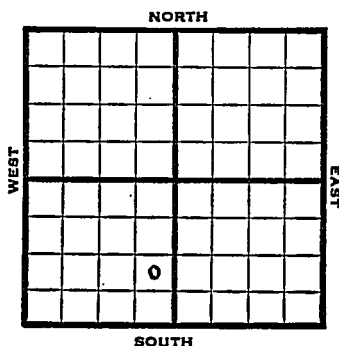

1952 Elev. 2123' REPORT

1/30 8" @ 154'
Drlg. 2205'
2/6 8" @ 154' Heeb. 3360 Lans. 3407
DST 3426-3500, 45 mins. 65' OCM
440# BHP Drlg. 3540'
2/15 D&A TD 3725
8" @ 154'
Heeb. 3360 Lans. 3407
DST 3426-3500 open 45 min.
rec. 65' ocm
Cong. 3650 Arb. 3700-25 TD
D&A

ABANDONED

County Ellis State Kansas
 Sec. 30 (^{Blk.}_{Twp.}) 12 (^{Sur.}_{Rge.}) 17W Map No.

Operator B & R Drlg.
 Well No. 1 Farm Staab

Elev. 2123 Location NE SE SW



1080 Ft. From S Line SW

330 Ft. From E Line Quarter

1st. Report JAN 30 1952

Completion


Remarks CRA & Westgate-IHM

Spudding Date

Drlg. Data Wildcat

8" @ 154 Drlg. 2205

J. G. McGEHEE

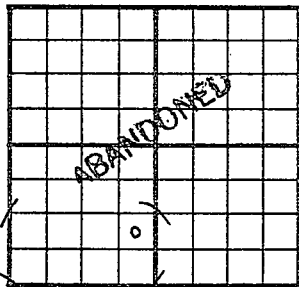County Ellis State KansasSec. 30 (Blk. 12 (Sur. 17W Map No.)
(Twp.) (Rge.)Operator B & R Drlg.Well No. 1 Farm StaabElev. 2123 Location NE SE SW1080 Ft. From S Line SW330 Ft. From E Line Quarter1st. Report Completion FEB 13 1952Remarks WildcatSpudding Date Drlg. Data D & A TD 37258" @ 154 Heeb. 3360 Lans. 3407DST 3426-3500 open 45. min. Rec. 65' ocmCong. 3650 Arb. 3700-25 TDD & A

J. G. McGEHEE