

Ellis


KANSAS

SECTION 31 TOWNSHIP 12 RANGE 17 W

WELL NO. #1 Karlin "A"

COMPANY Thunderbird Drlg.

NORTH

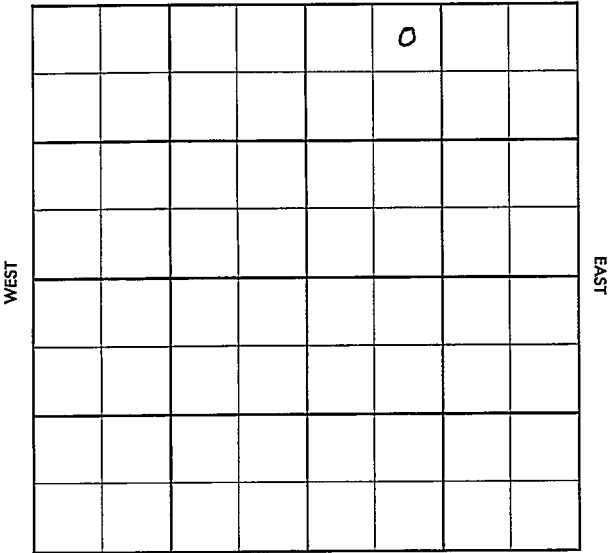

SOUTH

Ellis

KANSAS

SEC.	TWP.	R..
31	12	17W

WELL NO.

#1 Karlin "A"

FARM

COMPANY

Thunderbird Drll g

CONTRACTOR

Co. Tools

Wildcat

_____ Ft. from N. Line

_____ Ft. from S. Line

_____ Ft. from E. Line

_____ Ft. from W. Line

NE NW NE

		NORTH			
			0		
		SOUTH			

1955

ELEVATION

2070'

REPORT

10/26

R U R

11/9

Comm 10-24-55

8 5/8" @ 202'

Anh 1305

H 3302

Tr 3323

Dg 3340

L 3350

A 3623

TD 3635

DST 3625-35 open 1 hr rec 300' msW
930#

D & A

ABANDONED

County

15119

Elev.

Sec.

27

Two.

72

Res.

17N

Company

Thunderbird Drlg.

Farm Name

Kerlin "A"

No. 1

TOPS <i>f</i>	DEPTH	LOG	DATUM
Anh. <i>f</i>			
Tr. <i>f</i>			
H.			
Tr.			
Dg.			
Bl.			
L.			
K.C.			
B.K.C.			
Ce.			
C.			
M.			
M.			
K.			
Mz.			
Me.			
V.			
S.			
S.			
A.			
R.			
P.C.			
G.			
T.D.			

Loc. in Sec.

NYC NYJ NYF

Geol.

Contr	1	2	
1	1	2	3	

Co. tools

Pool

Wildcat

FIRST REPORT
OCT 28 '55

Date Comm.

R U R

Co.

Use:


No.

585



County Elvis Elev. 2070
 Sec. 31 Twp. 12 Rge. 17W
 Company Thunderbird Drlg.
 Farm Name Karlin "B" "A" No. 1

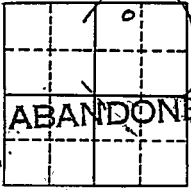TOPS	DEPTH	LOG	DATUM	Loc. in Sec.
Anh.	<u>1305</u>			NE NW NE
Tr.	<u>3302</u>		<u>1232</u>	
Dg.	<u>3323</u>		<u>1253</u>	
BL.	<u>3340</u>		<u>1270</u>	
L.	<u>3350</u>		<u>1280</u>	Geol.
K.C.				Contr.
B.K.C.				Co. tools
Ce.				Pool
C.				Wildcat
M.				
M.				
K.				
Mz.				
Ma.				
V.				
S.				
S.				
A	<u>3623</u>		<u>1553</u>	
R.				ABANDONED
PE.				
G.				
T.D.	<u>3635</u>			

Date Comm. 10-24-55 NOV 9 1955
8 5/8" @ 202 DST 3625-35 open 1 hr.
rec. 300' msw 930#

D & A