

22-12-33W 81

SIDE ONE

STATE CORPORATION COMMISSION OF KANSAS OIL & GAS CONSERVATION DIVISION

WELL COMPLETION OR RECOMPLETION FORM ACO-1 WELL HISTORY

DESCRIPTION OF WELL AND LEASE

Operator: license # 5363 name BEREXCO INC address 970 Fourth Financial Center City/State/Zip Wichita, KS 67202

Operator Contact Person Max Houston Phone 1-316-265-3311

Contractor: license # 6033 name Murfin Drilling CO.

Wellsite Geologist Steve Kreider Phone 1-316-265-5370

PURCHASER NA

Designate Type of Completion [X] New Well [] Re-Entry [] Workover

- Oil, Gas, Dry, SWD, Inj, Other, Temp Abd, Delayed Comp.

If OWWO: old well info as follows: Operator, Well Name, Comp. Date, Old Total Depth

WELL HISTORY

Drilling Method: [X] Mud Rotary [] Air Rotary [] Cable

Spud Date 11/10/84 Date Reached TD 11/18/84 Completion Date 11/19/84

Total Depth 4748 PBDT

Amount of Surface Pipe Set and Cemented at 338 feet

Multiple Stage Cementing Collar Used? [] Yes [] No

If Yes, Show Depth Set feet

If alternate 2 completion, cement circulated from feet depth to w/ SX cmt

API NO. 15-109-20,358

County Logan

C N/2 SW (location) Sec 22 Twp 12S Rge 33 W

1980 Ft North from Southeast Corner of Sec 3960 Ft West from Southeast Corner of Sec (Note: locate well in section plat below)


Lease Name Gilkerson Well# 2

Field Name

Producing Formation NA

Elevation: Ground 3102 KB 3107

Section Plat

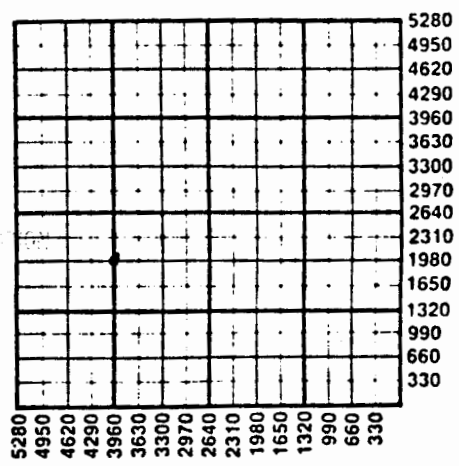

DEC 18 1984

WATER SUPPLY INFORMATION

Source of Water:

Division of Water Resources Permit #

[] Groundwater Ft North From Southeast Corner (Well) Ft. West From Southeast Corner Sec Twp Rge [] East [] West

[] Surface Water Ft North From Southeast Corner (Stream, Pond etc.) Ft West From Southeast Corner Sec Twp Rge [] East [] West

[X] Other (explain) HAULED (purchased from city, R.W.D.#)

Disposition of Produced Water: [] Disposal [] Repressuring

Docket #

INSTRUCTIONS: This form shall be completed in duplicate and filed with the Kansas Corporation Commission, 200 Colorado Derby Building Wichita, Kansas 67202, within 90 days after completion or recompletion of any well. Rules 82-3-130 and 82-3-107 apply.

Information on side two of this form will be held confidential for a period of 12 months if requested in writing and submitted with the form. See rule 82-3-10 for confidentiality in excess of 12 months.

One copy of all wireline logs and drillers time log shall be attached with this form.

