

3-12-34W

STATE CORPORATION COMMISSION OF KANSAS
OIL & GAS CONSERVATION DIVISION

WELL COMPLETION OR RECOMPLETION FORM
ACO-1 WELL HISTORY

DESCRIPTION OF WELL AND LEASE

Operator: license # 5364
name BEREN CORPORATION
address 970 Fourth Financial Center
City/State/Zip Wichita, KS 67202

Operator Contact Person Evan Mayhew
Phone 316-265-3511

Contractor: license # 5147
name BEREDCO INC.

Wellsite Geologist Sam Houston
Phone

PURCHASER
Designate Type of Completion
 New Well Re-Entry Workover

Oil SWD Temp Abd
 Gas Inj Delayed Comp.
 Dry Other (Core, Water Supply etc.)

If ~~OWO~~: old well info as follows:
Operator
Well Name
Comp. Date Old Total D

WELL HISTORY

Drilling Method: Mud Rotary Air Rotary Cable
12/19/88 12/31/88 1-17-89
Spud Date Date Reached TD Completion Date

4770' 4640'
Total Depth PBD

Amount of Surface Pipe Set and Cemented at 343 feet

Multiple Stage Cementing Collar Used? Yes No

If Yes, Show Depth Set 2678 feet

If alternate 2 completion, cement circulated
from 2675 feet depth to Surface w/ 650 SX cml

API NO. 15-109-20,469

County Logan

SE NE NW Sec 3 Twp 12S Rge 34W West

4290 Ft North from Southeast Corner of Section
2970 Ft West from Southeast Corner of Section
(Note: locate well in section plat below)


Lease Name R.E.B. Well# 2

Field Name

Injection
Producing Formation Kansas City

Elevation: Ground 3215 KB 3220

Section Plat

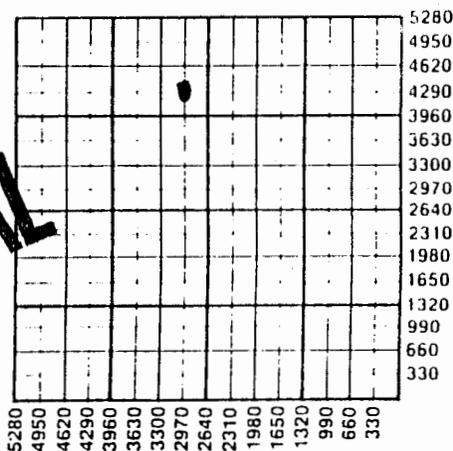

RECEIVED
STATE CORPORATION COMMISSION
JAN 19 1989
CONSERVATION DIVISION
Wichita, Kansas
CONFIDENTIAL

WATER SUPPLY INFORMATION

Source of Water:
Division of Water Resources Permit #

Groundwater Ft North From Southeast Corner and
(Well) Ft West From Southeast Corner of
Sec Twp Rge East West

Surface Water Ft North From Southeast Corner and
(Stream, Pond etc.) Ft West From Southeast Corner
Sec Twp Rge East West

Other (explain) Hauled - Fritzier Trucking
(purchased from city, R.W.D.#)

Disposition of Produced Water: Disposal Repressuring

Docket #

INSTRUCTIONS: This form shall be completed in duplicate and filed with the Kansas Corporation Commission, 200 Colorado Derby Building, Wichita, Kansas 67202, within 90 days after completion or recompletion of any well. Rules 82-3-130 and 82-3-107 apply.

Information on side two of this form will be held confidential for a period of 12 months if requested in writing and submitted with the form. See rule 82-3-107 for confidentiality in excess of 12 months.

A copy of all wireline logs and drillers time log shall be attached with this form. Submit CP-4 form with all plugged wells. Submit CP-111 form with temporarily abandoned wells.

requirements of the statutes, rules, and regulations promulgated to regulate the oil and gas industry have been fully complied with and the statements herein are complete and correct to the best of my knowledge.

Signature: Evan C. Mayhew
Evan C. Mayhew
Engineer Date 1-17-89

Notary Public: Perry Seibel
Subscribed and sworn to before me this 17 day of January 19 89
Expires 3-20-90

KANSAS GEOLOGICAL SURVEY
WICHITA BRANCH

K.C.C. OFFICE USE ONLY
 Letter of Confidentiality Attached
 Wireline Log Received
 Drillers Timelog Received
Distribution
 KCC SWD/Rep NGPA
 KGS Plug Other (Specify)

Form ACO-1 (7-84)

JAN 21 1989