
FORM 51 25M 8-50 WESTERN Ellis KANSAS

Section 34 Township 12 Range 18W

Well No. #1 Crissman

Company Petroleum Inc.

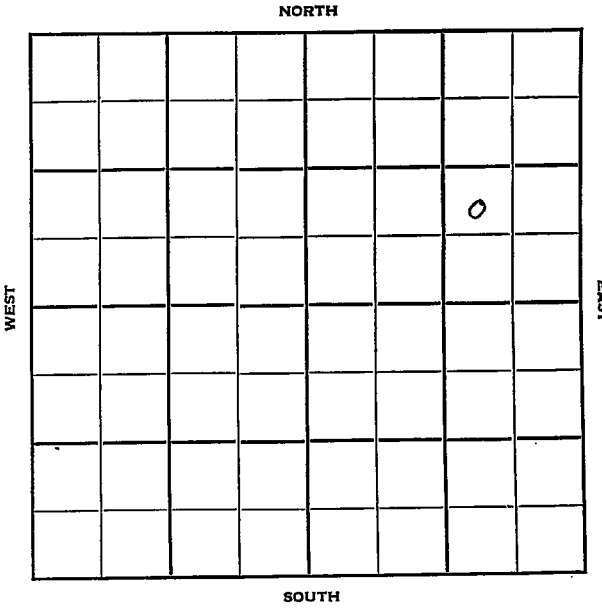

FORM 252-B
10M 8-51 TPCO.

Ellis KANSAS ✓

Sec. 34 Twp. 12 R. 18 W

Well No. # 1 Crissman Farm

Petroleum Inc. Company

Garvey Contractor

Wildcat


Ft. from N. Line

990 Ft. from S. Line

990 Ft. from E. Line

Ft. from W. Line

NW SE NE

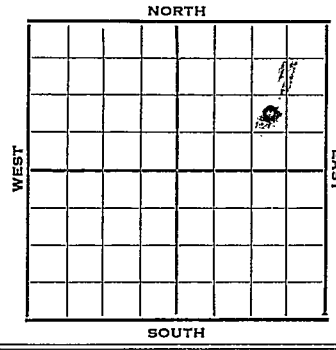

1952	Elev. 2107' REPORT
9/4	Spud 8-28-52 8" @ 235 Anhy 1400' Drlg. 2670'
9/10	Spud 8-28-52 D&A TD 3677 8" @ 235 Anhy 1400 Heeb. 3345 Tor. 3367 Lans. 3393 DST 3397-3430 opn ½ hr. Rec. 5'mud 0# DST 3451-90 opn 40 min. Rec. 58' mud 5' ocm 1080# DS 3541-95 opn 40 min. Rec. 15'mud 0# Arb. 3658 DST 3659-62 opn ½ hr. Rec. 30' socm 830# DST 3661-67 opn ½ hr. Rec. 70' vsocm DST 3667-77 opn 1hr. Rec. 120' sw 75# D&A ABANDONED

FORM 275 FOR SALE BY KANSAS BLUE PRINT CO.


County Ellis State Kansas

Sec. 34 (Blk. Twp.) 12 (Sur. Rge.) 18W Map No.

Operator Petroleum Inc.

Well No. 1 Farm Crissman

Elev. 2107 Location NW SE NE

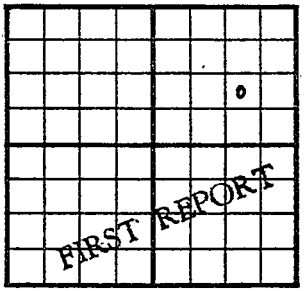

990 Ft. From S Line NE

990 Ft. From E Line Quarter

1st. Report Sep 4 1952

Completion

Remarks

Garvey - Contr.

Spudding Date 8-28-52

Drlg. Data Wildcat

8" @ 235 Anhy 1400 drlg. 2670

J. G. McGEHEE

FORM 275 FOR SALE BY KANSAS BLUE PRINT CO.


County Ellis State Kansas

Sec. 34 (Blk. Twp.) 12 (Sur. Rge.) 18W Map No.

Operator Petroleum Inc.

Well No. 1 Farm Crissman

Elev. 2107 Location NW SE NE

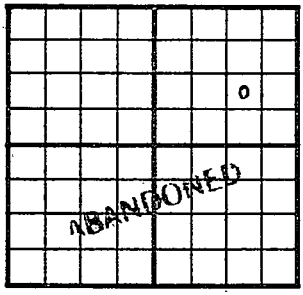

990 Ft. From S Line NE

990 Ft. From E Line Quarter

1st. Report

Completion SEP 1 0 1952

Remarks Wildcat

Garvey - Contr.

Spudding Date 8-28-52

Drlg. Data D & A TD 3677

8" @ 235 Anhy 1400 Heeb. 3345

Tor. 3367 Lans. 3393 DST 3397-3430

open ½ hr. Rec. 5' mud 0# DST 3451-

90 open 40 min. Rec. 58' mud 5' ocm

1080# DST 3541-95' open 40 min. Rec.

15' mud 0# Arb. 3658 DST 3659-62

open ½ hr. Rec. 30' socm 830#

DST 3661-67 open ½ hr. Rec. 70' vsocm

DST 3667-77 open 1 hr. Rec. 120' sw

75#

D & A

J. G. McGEHEE