


Section 35 Township 12 Range 18W

Well No. #4 A. Jensen

Company Texas Company

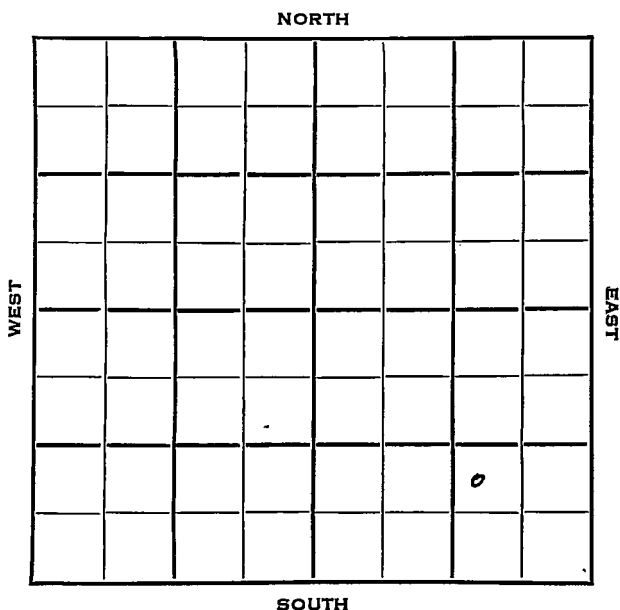

KANEAS

WELL NO.


COMPANY

CONTRACTOR

NW Ubert Pool

NORTH

_____ Ft. from W. Line

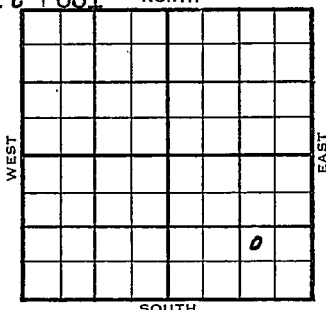

NW SE SE

4/7 Spud 3-31-54
10" @ 200'
Plattsmouth 3076'
Drlg 3340'


4/14 drlg.3340'

4/21 Spud 3-31-54 Oil well TD 3635
10" @ 200 Plattsmouth 3076 Heeb 331
Lans. 3364 Arb. 3616
DST 3619-35 open 1 hr rec 620' oil
120' MCO 600# TD 3635 7" @ 3623
CO to 3635 FU 1500' oil 1 hr.
S/5 BOPH 4 hr. P/60 BO 10 hr.
Comp. 25 BOPD

COMPLETED

J. G. McGEHEE

County Ellis State Kansas
 Sec. 35 (Blk.) 12 (Sur.) 18W Map No. _____
 Operator Texas Company
 Well No. 4 Farm A. Jensen
 Elev. 2092 Location NW SE SE

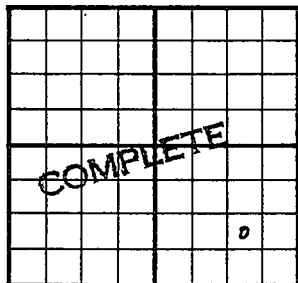

990 Ft. From S Line SE
990 Ft. From E Line Quarter
 1st. Report _____
 Completion APR 21 1954
 Remarks NW Ubert Pool
Noble Drlg. - Contr.
 Spudding Date 3-31-54

Drlg. Data Oil well TD 3635
10" @ 200 Plattsmouth 3076 Heeb. 3315
Lans. 3364 Arb. 3616 DST 3619-25
open 1 hr. Rec. 620' oil 120' mco
600# TD 3635 7" @ 3623 CO to 3635
FU 1500' oil 1 hr. S/ 5 boph 4 hr.
P/ 60 bo 10 hr. Comp. 25 bopd

J. G. McGEHEE