


Section 35 Township 12 Range 18 W

Well No. # 6 Andrew Jensen

Company Texas Company

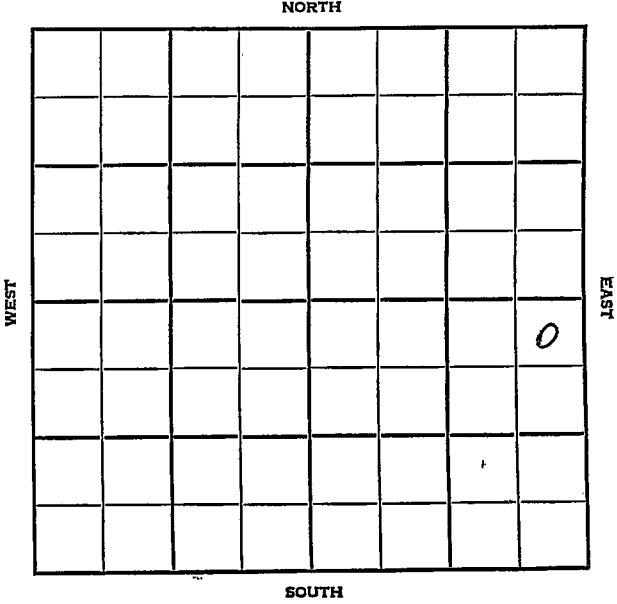

SEC. 35	TWP. 12	R. 18W
------------	------------	-----------


WELL NO. #6 Andrew Jensen FARM

COMPANY Texas Company

CONTRACTOR Powell

NW Ubert Pool NORTH

330 Ft. from N. Line
 _____ Ft. from S. Line
 330 Ft. from E. Line
 _____ Ft. from W. Line

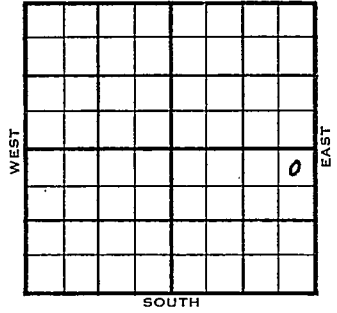

NE NE SE

1955	ELEVATION 2091'	REPORT
------	--------------------	--------

3/16
 5/25

Spud 3-14-55
 10" @ 197'
 WOC

Top 3071; Heeb 3309; Tor 3333; Lsg 3361; Chero 3592; Arb 3601; TD 3643; 10" 197; DST 3524-27 open 1 hr weak blo 15 min, rec only vsocm, 75#; DST 3542-94 open 1 hr rec 30' socm, 100#. DST 3616-33 open 1 hr, rec 300' hocm, 310#; RTD 3632; 7" 3621; CO to TD; swb 5 1/2 bo no wtr. 4 hrs; 500 A; test 16 bo 2 BW 4 hrs; pmp 6 bo plus tee. wtr. 24 hrs test 38 goph, 1000 A; swb 21 bo no wtr. 16 hrs; pmp 7 bo no wtr 24 hrs from Arb 3621-43

COMPLETED

County **Ellis** State **Kansas**

Sec. **35** (Blk. Twp.) **12** (Sur. Rge.) **18W** Map No.

Operator **Texas Company**

Well No. **6** Farm **Andrew Jensen**

Elev. **2091** Location **NE NE SE**

330 Ft. From **N** Line **SE**

330 Ft. From **E** Line **Quarter**

Ist. Report **MAR 16 1955**

Completion

Remarks

Powell - Contr.

Spudding Date **3-14-55**

Drlg. Data **NW Ubert Pool**

10" @ 197 WOC

FABEN-GILSTRAP