

35

12

18 W

Section _____ Township _____ Range _____

Well No. # 1 Hans Jensen

Company Texas Company

NORTH

							0

WEST

EAST

SOUTH

Sec. 35 Twp. 12 R. 18W

Well No. #1 Hans Jensen Farm

Texas Co. Company

Powell Drlg. Contractor


330 Ft. from N. Line

 Ft. from S. Line

330 Ft. from E. Line

 Ft. from W. Line

NE NE NE

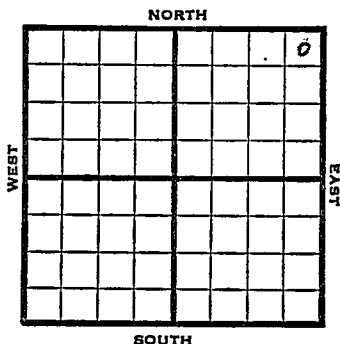

1953 Elev. 2085' REPORT

6/3 Spud 5-29-53
10" @ 1331'
WOC

6/10 Lans 3352,
DST 3426-54 1 hr, 1310' SW
855# 30"
Drlg 3460'

6/17 Spud 5-29-53
D & A
TD 3708'
10" @ 1331'
DST 3426-54 opn 1 hr, rec 310' sw
855# SCHLUMBERGER TOPS: Anhy 1324,
Top 3068, Heeb 3304, Tor 3328, Lans
3357, Cong 3610
TD 3708'
D & A

ABANDONED

County Ellis State Kansas
 Sec. 35 (Blk.) 12 (Sur.) 18W Map No.
 Operator Texas Company
 Well No. 1 Farm Hans Jensen
 Elev. _____ Location NE NE NE

							o

FIRST REPORT


330 Ft. From N Line NE
330 Ft. From E Line Quarter
 1st. Report JUN 3 1953
 Completion _____
 Remarks _____
Powell Drlg. - Contr.
 Spudding Date 5-29-53

Drlg. Data

10" @ 1331 WOC

J. G. McGEHEE

County Ellis State Kansas
 Sec. 35 (Blk. 12 (Sur. 18W Map No.
 (Twp.) (Rge.)
 Operator Texas Company
 Well No. 1 Farm Hans Jensen
 Elev. 2085 Location NE NE NE

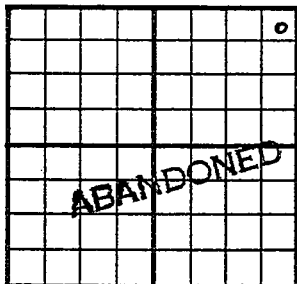

330 Ft. From N Line NE
330 Ft. From E Line Quarter

Ist. Report

Completion JUN 17 1953

Remarks

Powell Drlg. - Contr.

Spudding Date 5-29-53

Drlg. Data D & A TD 3708

10" @ 1331 DST 3426-54 open 1 hr.

Rec. 310' sw 855# SCHLUMBERGER TOES

Anhy 1324 Top. 3068 Heeb. 3304

Tor. 3328 Lans. 3357 Cong. 3610

TD 3708

D & A

J. G. McGEHEE