


Section 36 Township 12 Range 18 W

Well No. # 2 Schmidt

Company TransEra et al

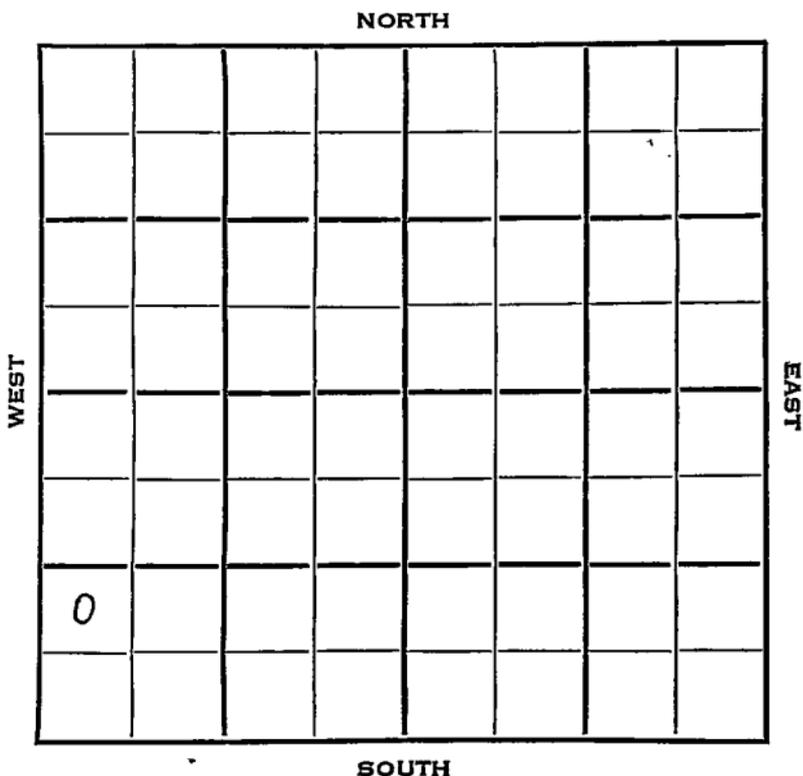

(Information Brought Forward)

1954
3/3

DST 3430-90', opn 1 hr., rec. 30'
o & gcm, 1920' free oil, 900#
DST 3493-3548', opn 1 hr., rec. 1175'
oil, 1000#
DST 3550-67', opn 1 hr., rec. 12' socm,
O#
TD 3574'
5" @ 3573'
Arb. 3572'
DD 3598', 1 boph 1000A
S/2 boph
DD 3604', 2000A, S/16 boph
Comp. 25 bopd

COMPLETED

1956
3/28

O.W.W.O.

OTD 3604' 5" @ 3573 P/50 BOPD
36/3482-87 1000 A
Comp. 145 BOPD. DUAL COMP.
L. 3322' Arb. 3572',
TD 3604'

FIRST REPORT

COMPLETED

County Ellis State Kansas

Sec. 36 (Blk.) 12 (Sur. Rge.) 18W Map No.

Operator Trans-Era etal.

Well No. 2 Farm Schmidt

Elev. 2071 Location NW SW SW

990 Ft. From S Line SW

330 Ft. From W Line Quarter

1st. Report

Completion MAR 3 1954

Remarks NW Ubert Pool

Trans-Era - Contr.

Spudding Date 2-1-54

Drig. Data Oil well TD 3604

8" @ 188 Heeb. 3277 Lans. 3322

DST 3324-85 open 1 hr. Rec. 370' gcm

420' oil & gcm 600' oil 5' wtr.

1000# DST 3390-3425 open 1/2 hr. Rec.

180' gcm 120' o & w 240' g & ocm

300' socw 850# DST 3430-90 open 1 hr.

Rec. 30' o & gcm 1920' free oil 900#

DST 3493-3548 open 1 hr. Rec. 1175' oil

1000# DST 3550-67 open 1 hr. Rec. 12'

socm 0# TD 3574 5" @ 3573 Arb. 3572

DD 3598 1 boph 1000 A S/ 2 boph

DD 3604 2000 A S/ 16 boph

Comp. 25 bopd

