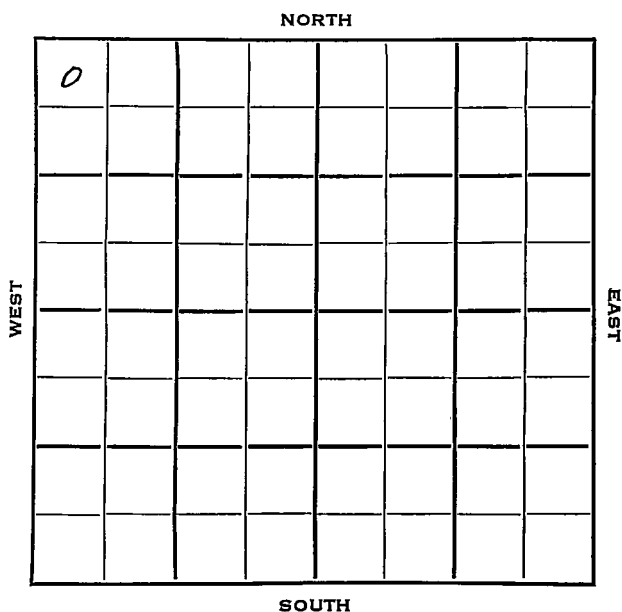


Section 36 Township 12 Range 18WWell No. #2 JensenCompany Jones, Shelburne & Farmer

Ellis

KANSAS

12

18W


Sec. 36 Twp. _____ R. _____Well No. #2 Jensen Farm _____Jones, Shelburne & Farmer Company _____J-S-F Contractor _____330 Ft. from N. Line

_____ Ft. from S. Line

_____ Ft. from E. Line

330 Ft. from W. Line

NW NW NW

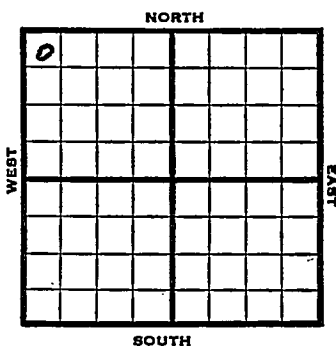

1953 Elev. 2076' REPORT

3/25 Spud 3-21-53
 8" @ 159
 Anhy 1313
 Drlg. 2215'

4/2 Drlg. 3530'

4/9 5" set

4/16 NR

4/23 NR

4/30 "

5/8 NR

5/21 NR

5/27 Spud 3-21-53

Oil Well

TD 3630'

8" @ 159'

Heeb 3289, Tor 3312, Lens 3333

DST 3365-74 opn 1 hr, rec 300' gas,
 125' muddy oil, 30' sw 1060#

DST 3392-3402 opn 1 hr, rec 900' gas,
 230' hocrn, 70' clean oil, 945#

B KC 3556, Cong 3590,

TD 3630'

OVER

1953

Information brought forward

5/27 5" @ 3630'
18/ 3510-16 18/ 3498-3504 1000 A
S/ 10 boph 3 hr.
Comp. 254 bopd 15% wtr.

COMPLETED

County Ellis State Kansas
 Sec. 36 (Blk.) 12 (Sur.) 18W Map No.
 Operator Jones, Shelburne & Farmer
 Well No. 2 Farm Jensen
 Elev. Location NW NW NW

0							

330 Ft. From N Line NW
330 Ft. From W Line Quarter
 1st. Report MAR 25 1953
 Completion
 Remarks
J-S-F - Contr.
 Spudding Date 3-21-53

Drilg. Data

8" @ 159 Anhy 1313 drilg. 2215

J. G. McGEHEE

County Ellis State KansasSec. 36 (Blk. 12 (Sur. 18 W Map No.Operator Jones, Shelbyburne & FarmerWell No. 2 Farm JensenElev. 2076 Location NW NW NW

0							

330 Ft. From N Line NW330 Ft. From W Line Quarter1st. ReportCompletion MAY 27 1953RemarksJ-S-F - Contr.Spudding Date 3-21-53Drig. Data Oil well TD 36308" @ 159 Heeb. 3289 Tor. 3312Lans. 3333 DST 3365-74 open 1 hr.Rec. 300' gas 125' muddy oil 30' sw1060# DST 3392-3402 open 1 hr. Rec.900' gas 230' hoom 70' clean oil945# B KC 3556 Cong. 3590 TD 36305" @ 3630 18/ 3510-16 18/ 3498-35041000 A S/ 10 boph 3 hr.Comp. 254 bopd 15% wtr.

J. G. McGEHEE