


Section 36 Township 12 Range 18 W

Well No. # 1 Schmidt

Company Trans-Era

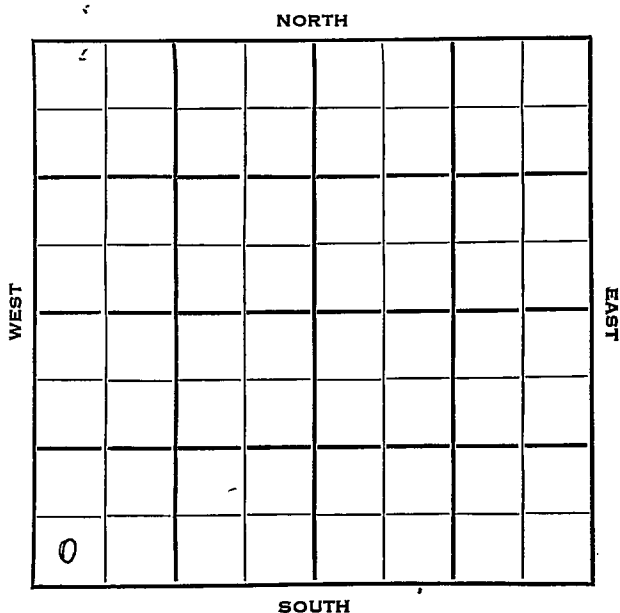

(Information Brought Forward)

1954

2/24

DD 3595', 1500A

DD 3598', 1500A

Comp. 25 bopd

COMPLETED

O.W.W.O.

1956

3/28

OTD 3596' 5" @ 3578 DD 3607

P/57 BOPD 5% wtr. 36/3506-12

24/3553-57 2500 A

Comp. 166 BOPD. DUAL COMP.

Lans 3333', Arb. 3577'

TD 3596'.

FIRST REPORT

COMPLETED

O.W.W.O.

FORM 513 REV. SUNRAY

OWWO

County **Elm** Elev. **2079**
 Sec. **36** Twp. **18N** Rge. **18W**
 Company **Trans-En**
 Farm Name **Schmidt** No. **1**

TOPS	DEPTH	LOG	DATUM	Loc. in Sec.
Anh.				SW SW SW
Tr.				
Dg.				
Bl.				
L.	3333			Geol. _____
K.C.				Contr. _____
B.K.C.				
Ce.				
M.				Pool
M.				Ubert
K.				
Mz.				
Mq.				
V.				
S.				FIRST REPORT COMPLETE
A	3577			
R.				
Pe.				
G.				MAR 28 '36
T.D.	3596			

Date Comm.

OPD 3596 5" @ 3578 DD 3607
P/ 57 bopd 5% wtr. 36/ 3506-12
2L/ 3553-57 2500 A Comp. 166 bopd
Dual Comp.

