

O.W.W.O.


Ellis

KANSAS

SECTION 36 TOWNSHIP 12 RANGE 18 W

WELL NO. #3 Schmidt

COMPANY Trans-Era

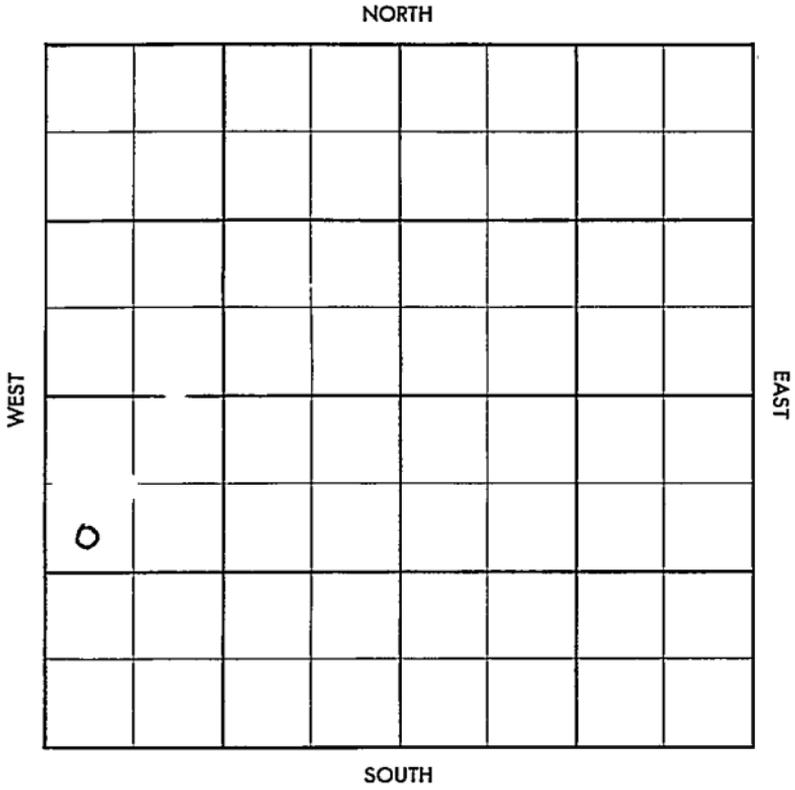

O.W.W.O.

Ellis

KANSAS

SEC.	TWP.	R..
36	12	18 W

WELL NO. \_\_\_\_\_

COMPANY # 3 Schmidt FARM

CONTRACTOR Trans-Era

NW. Ubert


\_\_\_\_\_ Ft. from N. Line

\_\_\_\_\_ Ft. from S. Line

\_\_\_\_\_ Ft. from E. Line

\_\_\_\_\_ Ft. from W. Line

SW NW SW

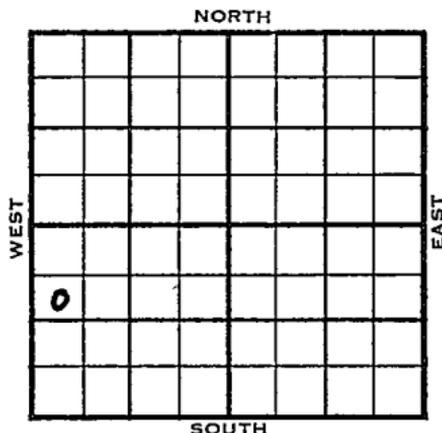

	ELEVATION	REPORT
1955	2076'	

11/9 5" @ 3598 DD 3618 18/3484-87  
 12/3492-94 12/3500-02 2500 A  
 Comp. 230 BOPD Dual Comp.  
 BL 3330', S. 3574'  
 TD 3599'

FIRST REPORT  
 COMPLETED

O.W.W.O.

1956  
 3/28 OTD 3618' 5" @ 3598 P/91 BOPD  
 18/3484-87 12/3500-02 2500 A  
 Comp. 86 BOPD DUAL COMP.  
 Lans. 3330' Arb. 3574'  
 TD 3618'

FIRST REPORT  
 COMPLETED

OWDD

County Wash Elev. \_\_\_\_\_  
 Sec. 36 Twp. 12 Rge. 18W  
 Company Trans-Era  
 Farm Name Schmidt No. 3

TOPS	DEPTH	LOG	DATUM	Loc. in Sec.
Anh.				SW NW SW
Tr.				
H.				
Tr.				
Dg.				
Bl.	3330			
L.				Geol. _____
K.C.				Contr. _____
B.K.C.				
Ce.				
C.				
M.				
M.				Pool
K.				NW Ubert
Mz.				
Mq.				
V.				
S.				
S.	3574			FIRST REPORT
A.				
R.				NOV 9 55
Pe.				
G.				
T.D.	3599			COMPLETE

Date Comm. 5m @ 3598 DD 3618 18/ 3404-87  
12/ 3492-94 12/ 3500-02 2500 A  
 Comp. 230 bopd Dual Comp.

O.W.W.O.



FORM 513 REV. SUNRAY

O.W.O.

County Illis Elev. 2076  
 Sec. 36 Twp. 12 Rge. 18W  
 Company Trans-Era  
 Farm Name Schmidt No. 3

TOPS	DEPTH	LOG	DATUM	Loc. in Sec.
Anh.				SW NW SW
Tp.				
H.				
Tr.				
Dg.				
Bl.				
L.	3330			Geol.
K.C.				Contr.
B.K.C.				
Ce.				
C.				
M.				Pool
M.				Übert
K.				
Mz.				
Me.				
V.				
S.				FIRST REPORT
S.	357h			COMPLETE
A.				
R.				
PE.				
G.				
T.D.	31.18			MAR 28 '56

Date Comm. OTD 3618 5" @ 3598 P/ 91 bopd  
18/ 348h-87 12/ 3500-02 2500 A  
Comp. 86 bopd Dual Comp.

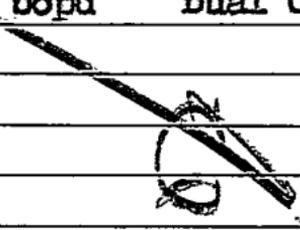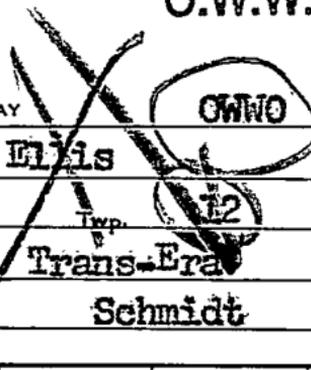

Co.

Lse.

No.

Sec.

T.

R.