


DX 78-1

Section 36 Township 12 Range 18W  
Well No. #4 Schmidt  
Company Trans-Era.

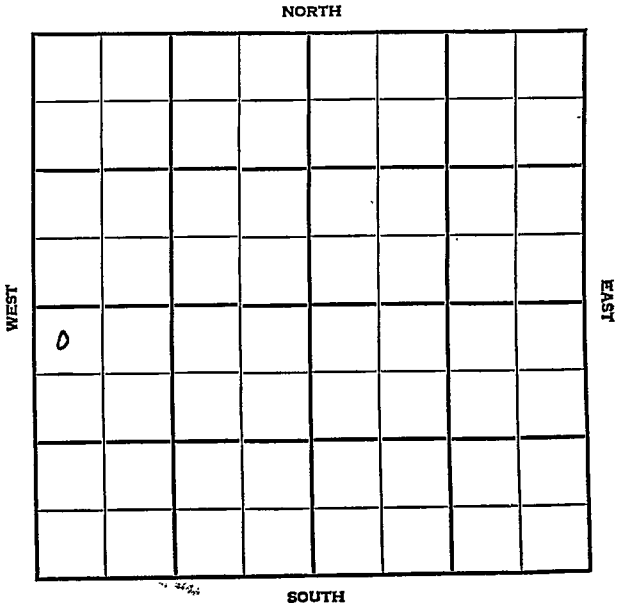


SEC.	36	TWP.	12	R.	18W
------	----	------	----	----	-----

WELL NO. #4 Schmidt. FARM

COMPANY Trans-Era.

CONTRACTOR Co. Tools

330 \_\_\_\_\_ Ft. from N. Line  
 \_\_\_\_\_ Ft. from S. Line  
 \_\_\_\_\_ Ft. from E. Line  
 330 \_\_\_\_\_ Ft. from W. Line

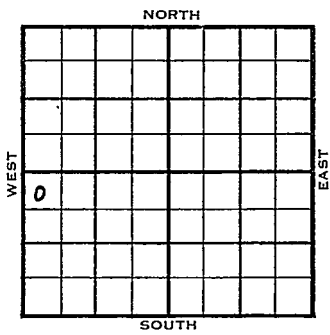

NW NW SW

1954	ELEVATION 2078'	REPORT
------	--------------------	--------

12/22 Spud 12-14-54  
 8" @ 202'  
 Drlg. 2777'

1955  
 2/23 Spud 12-14-54  
 Oil Well  
 TD 3647'  
 8" @ 202'  
 Heeb 3288' Lans 3333'  
 DST 3522'-64' opn 1 hr, rec 62' Muddy  
 Oil, 900# Arb. 3604'  
 TD 3611'  
 5" @ 3598'  
 DD 3647' 20 goph 16/ 3629-33 B/ wtr.  
 1000 A channelled. sq. CO to 3634  
 32/ 3629-33 500 A S/ 5.7 bw 3 hr.  
 SP 3625 20/ 3619-24 500 A S/ 14 go  
 12 gwph sd-oil-frac. S/ 4 bfph 90%  
 Wtr. PB 3580'  
 20/ 3571-76 B/ 10 go 2' gw. 10 hr.  
 500 A S/ 2 1/2 boph PB 3566  
 21/ 3558-65 S/ 2 1/3 boph 1500 A  
 S/ 4 1/2 boph 4 hr. PB 3550'  
 20/ 3534-39 16/ 3542-46 FU 300' oil  
 1 hr. S/ 3 1/2 boph 5 hr. PB 3535'  
 20/ 3509-14 1000 A CO to 3580 S/ 6 1/2  
 boph 5 hr. Comp 50 bop **COMPLETED**





Dirg. Data

FORM

20/3509-14 1000 A -- 60 to 3580

S/6 1/2 bopd 5 hr. Comp. 50 bopd.

MAR 1 1955