


Section 4 Township 12 Range 18W

Well No. #1 Schemer "B"

Company Petroleum Inc.

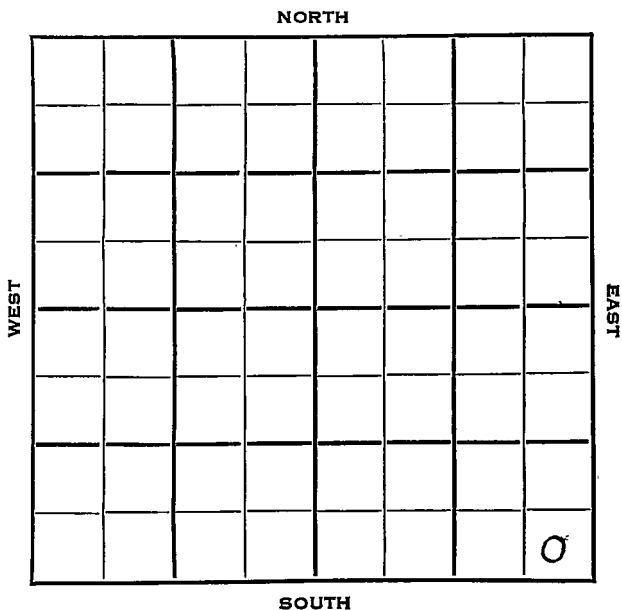

Ellis KANSAS

SEC.	TWP.	R.
4	12	18 W

WELL NO.

1 Schemer "B"

FARM

COMPANY

Petroleum Inc.

CONTRACTOR

Petroleum Inc.

Wildcat


_____ Ft. from N. Line

330 _____ Ft. from S. Line

330 _____ Ft. from E. Line

_____ Ft. from W. Line

SE SE SE

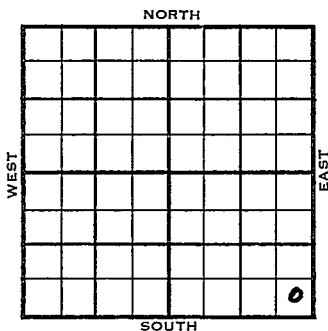

	ELEVATION	REPORT
1953	2129'	

9/23

MIR

9/30

8" @ 192'
 Anhy 1460, Heeb 3360, Lans 3405,
 Drlg 3472'

10/7

Spud 9-22-53 D & A TD 3722
 8" @ 192 Anhy 1460 Heeb 3360
 Lans 3405' Arb. 3697'
 TD 3722 D & A

ABANDONED

