


Section 6 Township 12 Range 17-W

Well No. #1 Meis

Company Wm Graham Oil

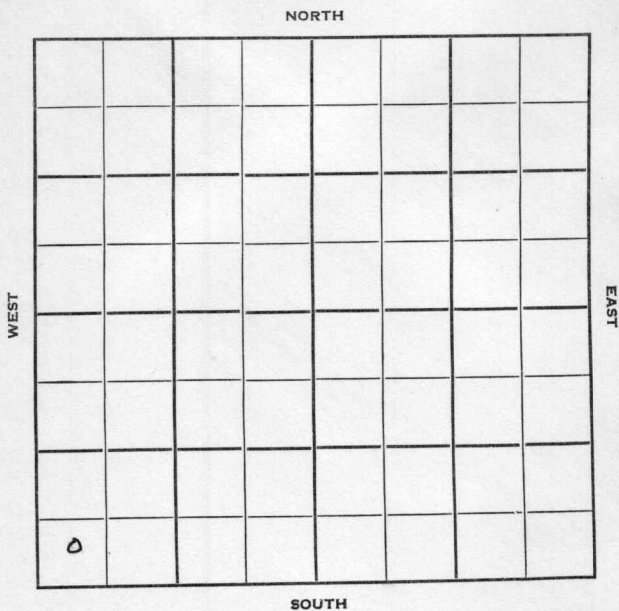

Sec. 6 Twp. \_\_\_\_\_ R. \_\_\_\_\_

Well No. #1 Meis Farm \_\_\_\_\_

Wm. Graham Oil Company \_\_\_\_\_

Contractor \_\_\_\_\_


\_\_\_\_\_ Ft. from N. Line

330' Ft. from S. Line

\_\_\_\_\_ Ft. from E. Line

330' Ft. from W. Line

SW SW SW

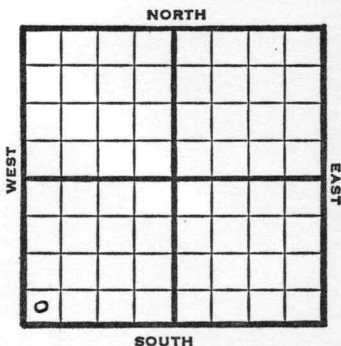

1950

Elev 2150'

REPORT

5/24

Drlg. 1500'

6/14

8" @160

Anhy 1394

Heeb 3400

Lans 3436

Cong 3654

Arb 3681

DST 3689-91, opn 30 min, rec 7' oil  
15' ocm

5" @ 3687

TD 3697

3000 acid

test 5 gal. oil ph

DD 3702

S/4 to 5 boph for 2 hrs

DD 3704

S/ 3/4 boph for 1 1/2 hr

FU 300' wtr in 1 hr

D&A

**ABANDONED**

Kansas

Map No. \_\_\_\_\_ Sec. 6 Twp. 12 R. 17W

Well No. 1 Meis

Wm. Graham Oil Company

Contractor

SW SW SW

\_\_\_\_\_ Ft. from N. Line

330

\_\_\_\_\_ Ft. from S. Line

\_\_\_\_\_ Ft. from E. Line

330

\_\_\_\_\_ Ft. from W. Line

SECTION PLAT

FIRST REPORT			
0			

Ellis

Location \_\_\_\_\_

Rig up \_\_\_\_\_

Drilling and Remarks:

Drlg. 1500

RECORD

Cased \_\_\_\_\_ in., \_\_\_\_\_ ft.

Sand \_\_\_\_\_

Gas \_\_\_\_\_

Oil \_\_\_\_\_

Total Depth \_\_\_\_\_

PRODUCTION

1st 24 hrs. Nat. \_\_\_\_\_

1st 24 hrs. after shot \_\_\_\_\_

Gas \_\_\_\_\_ Cu. Ft.

Dry Hole \_\_\_\_\_

Abandoned \_\_\_\_\_

Date

MAY 24 1950 19

J. E. TYRA Scout

Map No. \_\_\_\_\_ Sec. 6 Twp. 12 R. 17W

Well No. 1 Meis

Wm. Graham Oil Company

Contractor \_\_\_\_\_

SW SW SW

E1. 2150  
SECTION PLAT

\_\_\_\_\_ Ft. from N. Line

330 Ft. from S. Line

\_\_\_\_\_ Ft. from E. Line

330 Ft. from W. Line



Ellis County

Location \_\_\_\_\_

Rig up \_\_\_\_\_

Drilling and Remarks:

8" @ 160  
Anhy 1394  
Heeb. 3400  
Lans. 3436  
Cong. 3645  
Arb. 3681  
DST 3689-91

**RECORD**

Cased \_\_\_\_\_ in., \_\_\_\_\_ ft.  
Sand \_\_\_\_\_  
Gas \_\_\_\_\_  
Oil \_\_\_\_\_  
Total Depth 3704

**PRODUCTION**

1st 24 hrs. Nat. \_\_\_\_\_  
1st 24 hrs. after shot \_\_\_\_\_  
Gas \_\_\_\_\_ Cu. Ft.  
Dry Hole \_\_\_\_\_  
Abandoned \_\_\_\_\_

Date \_\_\_\_\_

JUN 14 1950 19

J. E. TYRA Scout

open 30 min.

Rec. 7' oil 15' ocm

5" @ 3687

TD 3697

3000 acid

test 5 gal. oil ph

DD 3702

S/ 4 to 5 boph for 2 hrs.

DD 3704

S/ 3/4 boph for 1 1/2 hr.

FU 300' water in 1 hr.

D & A

Location

Misc. \_\_\_\_\_

Pierce Map \_\_\_\_\_

France Map \_\_\_\_\_

Tracings \_\_\_\_\_

Land Wall Map \_\_\_\_\_

Land Small Map \_\_\_\_\_

Scout Cards \_\_\_\_\_

1950

NUC

RECORD

EF from W Line

EF from E Line

EF from S Line

EF from N Line


SECTION PLAT

Contractor

Company

Map No

Map No