Form 51-5M-12-36 Com'l


Ellis

KANSAS

Section 6 Township 12 Range 17-W

Well Number 1 - Karlin

Company Twin Drlg.

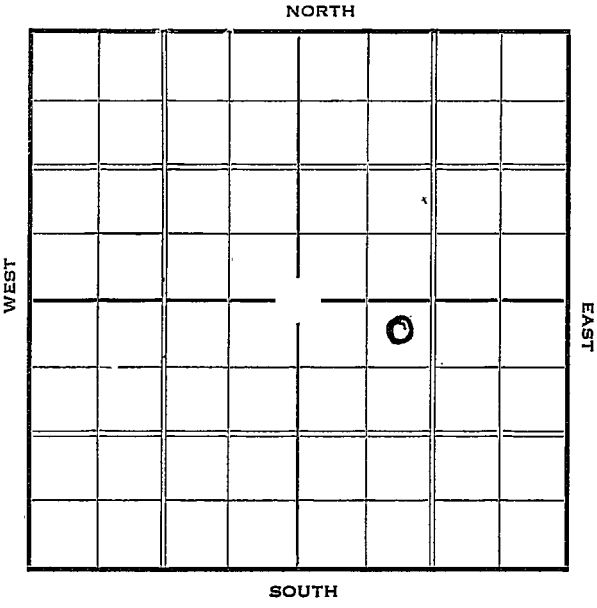

A—5M—2-37—Palace KANSAS Ellis

Sec. 6 Twp. 12 R. 17-W

Well No. #1 Karlin Farm

Twin Drlg. Company


330 Ft. from N. Line

Ft. from S. Line

Ft. from E. Line

990 Ft. from W. Line

Elev. 2162

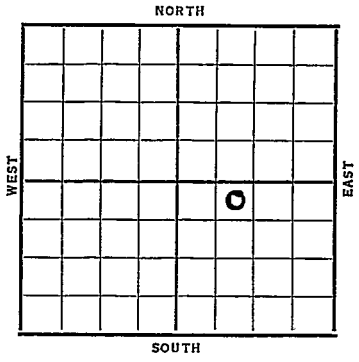

Date	REPORT
1937	
5/19	15" @ 33'.
	Drlg. 1114'.
5/28	Drlg. 2431'.
6/4	Drlg. 3263'.
6/11	Simp. 3645'. Osw. 3390'.
	S.O. 3430-35'. Sil. 3662'.
	T.D. 3667'. Sat. core.
6/19	5" @ 3662'. T.D. 3671'.
	75' oil. Will acidize.
6/25	5000 acid. Swab 50 bbls. per
	hour. 5 hrs. 2000' off btm.
7/2	On Potential.
7/9	" " "
7/16	Pumped 1096 oil in 16 hrs.
7/21	Sil 3662'
	5" @ 3662'
	TD 3676'
	5000 acid
	Pot 1632
	COMPLETED

Form 26—1M Bks.—2-29 Ellis KANSAS

Map No. 71 Sec. 6 Twp. 12 R. 17W

Well No. 1 - Karlin

Twin Dry Company

Contractor

FIRST REPORT

330 Ft. from N. Line


Ft. from S. Line

Ft. from E. Line

990 Ft. from W. Line

Twin Dry Co. has all but 10 A around dry hole in NESE.

SECTION PLAT

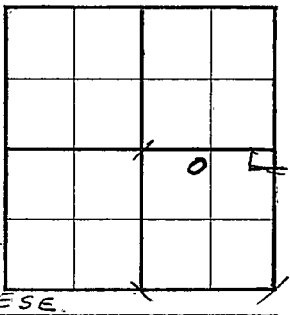

Location

Rig up

Drilling and Remarks:

15 - 33

Dlg - 1114.

RECORD

Cased in., ft.

Sand

Gas

Oil

Total Depth

PRODUCTION

1st 24 hrs. Nat.

1st 24 hrs. after shot

Gas Cu. Ft.

Dry Hole

Abandoned

Date MAY 19 1937

19

H. D. Hatfield Scout

Form 26—1M Bks.—2-29 Ellis

Map No. 71 Sec. 6 Twp. 12 R. 17 W

Well No. 1 - Karlin

Twin Orly Company

Contractor

COMPLETED


330 Ft. from N. Line

Ft. from S. Line

Ft. from E. Line

990 Ft. from W. Line

SECTION PLAT

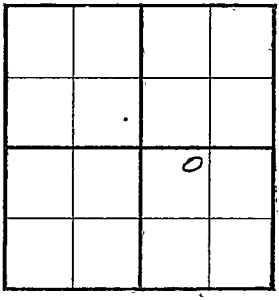

Location

Rig up

Drilling and Remarks:

5000 Acid

Pot - 1632

RECORD

Cased 5 in., 3662 ft.

~~Sand~~ Sil 3662

Gas

Oil

Total Depth 3676

PRODUCTION

1st 24 hrs. Nat.

1st 24 hrs. after shot

Gas Cu. Ft.

Dry Hole

Abandoned

Date

JUL 21 1937 19 H. D. Hatfield Scout