


Ellis

Section 6 Township 12 Range 17-W

Well No. 2 Karlin

Company Twin Drilling

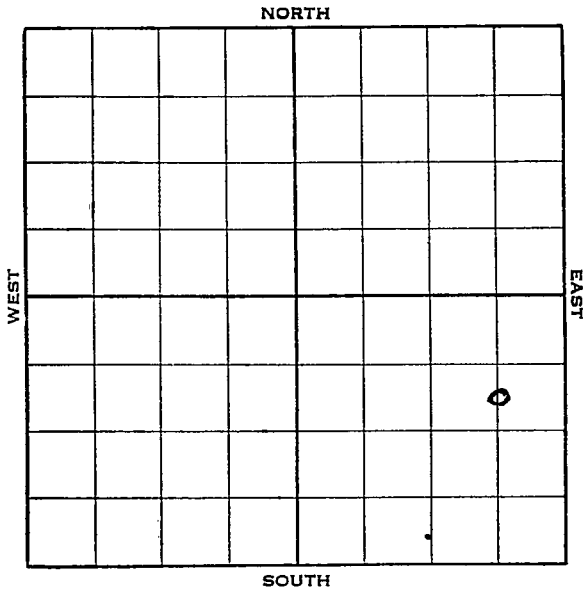

Sec. 6 Twp. 12 R. 17-W

Well No. #2 Karlin Farm
Twin Drilling Company


990 Ft. from N. Line

_____ Ft. from S. Line

660 Ft. from E. Line

_____ Ft. from W. Line

Elev. 2144

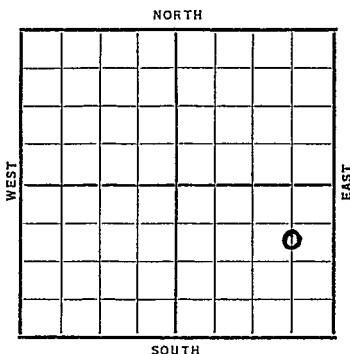

Date	REPORT
1938	
7/13	10" - 30'.
	8" - 161'.
	Lans. 3360'. Arb. 3638; Sat.
	Core. 6" - 3638'. T.D. 3632'.
	600' oil 6 hrs.
7/22	2500 acid. Swab 12 oil per
	hour off bottom. 4500 acid.
7/27	6" - 3638'.
	Arb. 3638'.
	T. D. 3662'.
	7000 acid.
	Potential 1225 bbls.
	COMPLETED

Ellis

KANSAS

Map No. 71 Sec. 6 Twp. 12 R. 17WWell No. 2 KarlinTwin Drilling Company

Contractor

FIRST REPORT

SECTION PLAT

990 C S L N E S E
Ft. from N. Line

____ Ft. from S. Line

660 Ft. from E. Line

____ Ft. from W. Line

			0

Location _____

Rig up _____

Drilling and Remarks:

10"-30

8"-161

Lans. 3360

Arb. 3638; Sat. Core

6" - 3638

T.D. 3662

600' Oil 6 hrs.

RECORD

Cased _____ in., _____ ft.

Sand _____

Gas _____

Oil _____

Total Depth _____

PRODUCTION

1st 24 hrs. Nat. _____

1st 24 hrs. after shot _____

Gas _____ Cu. Ft.

Dry Hole _____

Abandoned _____

Date

JUL 13 1938₁₉

H. D. Hatfield Scout

Ellis

KANSAS

Map No. 71Sec. 6Twp. 12R. 17WWell No. 2 KarlinTwin Drilling

Company

Contractor

COMPLETED

SECTION PLAT

C S L NE SE

990 Ft. from N. Line

_____ Ft. from S. Line

660 Ft. from E. Line

_____ Ft. from W. Line

			0

Location _____

Rig up _____

Drilling and Remarks:

7500 AcidPOT 1225

RECORD

Cased 6 in., 3638ft.Sand Arb 3638

Gas _____

Oil _____

Total Depth 3662

PRODUCTION

1st 24 hrs. Nat. _____

1st 24 hrs. after shot _____

Gas _____ Cu. Ft.

Dry Hole _____

Abandoned _____

Date

JUL 27 1938

19

H. D. Hatfield

Scout