

KANSAS


Form 51-5M-7-39-Palace

Ellis

Section 6 Township 12 Range 17-W

Well No. #3 Karlin

Company Twin Drilling

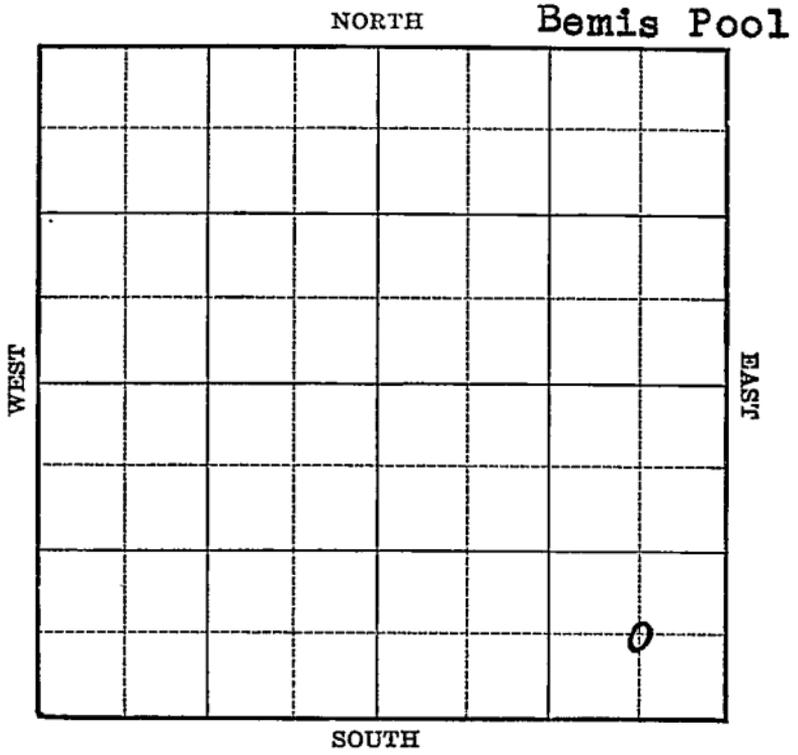

Sec. 6 Twp. 12 R. 17-W

Well No. #3 Karlin Farm

Twin Drilling Company
(Bemis)


Ft. from N. Line

660 Ft. from S. Line

660 Ft. from E. Line

Ft. from W. Line

Elev. 2146

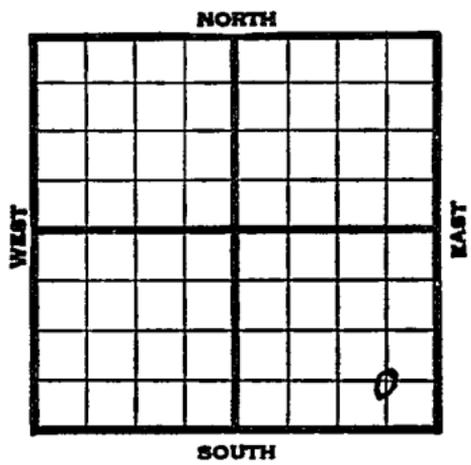

1940	REPORT
1/31	8" - 1100'
	Drlg. 1250'
2/8	Anhy 1365' Drlg. 2575'
2/15	Arb. 3639' 5" - 3639'
	T.D. 3641' RUST.
2/23	T.D. 3665' 400' oil
	1500 acid.
2/29	T.D. 3672' 2000 acid.
	Swab 30 bbls. a day.
3/8	" " " "
3/14	Shut down.
3/20	Arb. 3639'
	5" - 3639'
	T.D. 3672'
	5000 acid.
	Pump 380 bbls. plus 3% water.
	COMPLETED

Map No. 71 Sec. 6 Twp. 12 R. 17WWell No. 3 Karlin

Twin Drilling

Company

Contractor

FIRST REPORT

C SE SE

SECTION PLAT

			o

 Ft. from N. Line660 Ft. from S. Line660 Ft. from E. Line Ft. from W. Line

BEMIS POOL

Location Rig up

Drilling and Remarks:

8" - 1100

Drlg. 1250

RECORD

Cased in., ft.Sand Gas Oil Total Depth

PRODUCTION

1st 24 hrs. Nat. 1st 24 hrs. after shot Gas Cu. Ft.Dry Hole Abandoned

Date

JAN 31 1940 19

S. J. LEWIS Scout

Map No. 71 Sec. 6 Twp. 12 R. 17WWell No. 3 KarlinTwin Drilling

Company

Contractor

COMPLETED**C SE SE** Ft. from N. Line660 Ft. from S. Line660 Ft. from E. Line Ft. from W. Line**SECTION PLAT**

			o

SHUTTS POOLLocation Rig up

Drilling and Remarks:

*Cas & 3639**5" @ 3639**5000 acid**Pump. 380 + 3% Water***RECORD**Cased in., ft.Sand Gas Oil Total Depth 3672**PRODUCTION**1st 24 hrs. Nat. 1st 24 hrs. after shot Gas Cu. Ft.Dry Hole Abandoned

Date

MAR 20 1940₁₉S. J. LEWIS Scout