


Section 6 Township 12 Range 17-W

Well No. #⁶A Meis

Company Aylward Prod
Bemis Pool

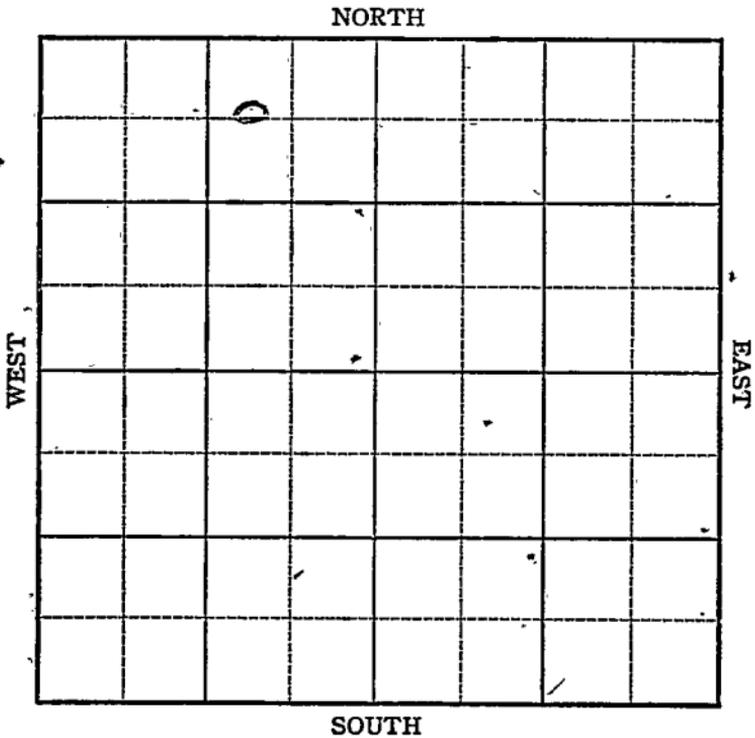

Sec. 6 Twp. 12 R. 17-W

Well No. # 1 Meis Farm

Aylward Prod Company


Bermis Pool

660 Ft. from N. Line

_____ Ft. from S. Line

990 Ft. from E. Line

_____ Ft. from W. Line

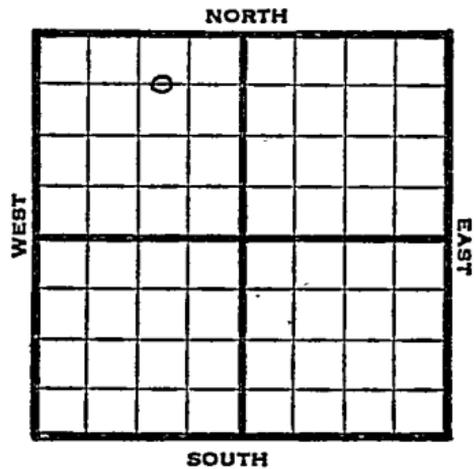

C W L NE NW

1947	Elev.	REPORT	2176'
6/18	Location		
6/24	"		
7/1	8' @ 1095 WOC		
7/8	Fishing 2930'		
7-16	Whipstock 1230 Drlg. 2935		
7/22	Lansing 3407' Arbuckle 3679-82 T.D. 5" @ 3680' RUST		
7/29	TD 3685' 8 gals. oil PH 12 hrs.		
8/6	3000 acid.		
8/13	"		
8/20	"		
8/27	Arbuckle 3679' 5" @ 3680' 3000 Acid Echo Pot 2692 oil & 7% W. Gr. 360 Total Depth 3685'		
COMPLETED			

Map No. _____ Sec. 6 Twp. 12 R. 17W

Well No. 1 Meis

Aylward Prod. Company

FIRST REPORT

Contractor

C W L NE NW

SECTION PLAT

660 Ft. from N. Line

_____ Ft. from S. Line

990 Ft. from E. Line

_____ Ft. from W. Line

	o		

Ellis County

Location X

Rig up _____

Drilling and Remarks:

RECORD

Cased _____ in., _____ ft.

Sand _____

Gas _____

Oil _____

Total Depth _____

PRODUCTION

1st 24 hrs. Nat. _____

1st 24 hrs. after shot _____

Gas _____ Cu. Ft.

Dry Hole _____

Abandoned _____

Date

JUN 1 8 1947 19

S. J. LEWIS Scout

Map No. 71 Sec. 6 Twp. 12 R. 17W

Well No. 6 Meis

Aylward Prod. Company

CORRECTION Contractor

C W L NE NW

SECTION PLAT

660 Ft. from N. Line

 Ft. from S. Line

990 Ft. from E. Line

 Ft. from W. Line

	o		

Ellis County

Location

Rig up

Drilling and Remarks:

Reported

#1 Meis

RECORD

Cased in., ft.

Sand

Gas

Oil

Total Depth

PRODUCTION

1st 24 hrs. Nat.

1st 24 hrs. after shot

Gas Cu. Ft.

Dry Hole

Abandoned

Date

JUL 2 1947 19

S. J. LEWIS Scout

Map No. 71 Sec. 6 Twp. 12 R. 17W

Well No. 6 Meis

Aylward Prod. Company

COMPLETE

Contractor

C W L NE NW

E. 2176
SECTION PLAT

660 Ft. from N. Line

_____ Ft. from S. Line

990 Ft. from E. Line

_____ Ft. from W. Line

	0		

Ellis County

Location _____

Rig up _____

Drilling and Remarks:

QX 2679
5' @ 2680
3000 @ 2680
Ech in Prod 269200
f 7 7/8 W.
26 2/8 W

RECORD

Cased _____ in., _____ ft.

Sand _____

Gas _____

Oil _____

Total Depth 7965

PRODUCTION

1st 24 hrs. Nat. _____

1st 24 hrs. after shot _____

Gas _____ Cu. Ft.

Dry Hole _____

Abandoned _____

Date

AUG 27 1947 19

S. J. LEWIS Scout