

DX 78-1

Ellis

KANSAS

Section 6 Township 12 Range 17 W

Well No. # 1 Meis "A"

Company Walters Drilg. Co.

NORTH

WEST

EAST

SOUTH

0

Ellis

KANSAS

SEC.	TWP.	R.
6	12	17 W

WELL NO. #.1 Meis "A" FARM

COMPANY

CONTRACTOR Walters Drlg. Co.


Co. tools
Bemis-Shutts Pool

990 Ft. from N. Line

Ft. from S. Line

990 Ft. from E. Line

Ft. from W. Line

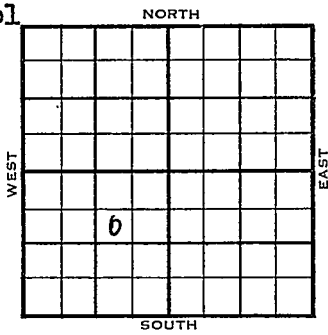

SW NE SW

1954	ELEVATION	REPORT
	2170 KB - 2168 DF	

9/22 Location

10/6 S pud 9-23-54 - D&A

TD 3735'

8-5/8" @ 218'

A Inhy 1408', Top 3148', Heeb 3381',

Lans 3427', B KC 3653', Cong 3680',

Simp. 3707', Arb. 3721'

TD 3735'

D&A

ABANDONED

