


KANSAS

Section 6 Township 12 Range 18-W

Well No. #1 Harman

Company Petroleum Inc.
Wildcat

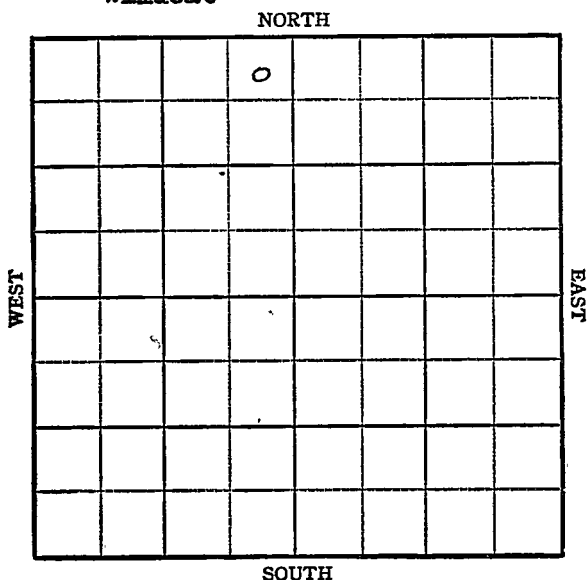

KANSAS

Ellis

Sec. 6 Twp. 12 R. 18 ^W

Well No. #1 Harman Farm

Petroleum Inc.

Company

Wildcat


330' Ft. from N. Line

 Ft. from S. Line

330' Ft. from E. Line

 Ft. from W. Line

NE NW

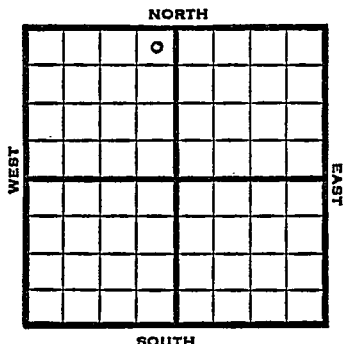

1948

Eli 2125'

R E P O R T

12/8

RUR

12/15

8" @ 357'

Drlg 2090'

12/22

Topeka 3160'

Lansing 3417'

Drlg 3510'

12/29

TD 3755'

Arb. 3725'

Aband.

ABANDONED

Map No. _____ Sec. 6 Twp. 12 R. 18W


Well No. 1 Harman

Petroleum Inc. Company

FIRST DEPOSIT Contractor

NE NW

SECTION PLAT

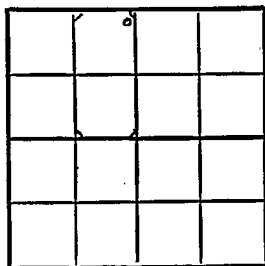

330 Ft. from N. Line

_____ Ft. from S. Line

330 Ft. from E. Line

_____ Ft. from W. Line

Ellis County

Location _____

Rig up _____

Drilling and Remarks:

R U R

RECORD

Cased _____ in., _____ ft.

Sand _____

Gas _____

Oil _____

Total Depth _____

PRODUCTION

1st 24 hrs. Nat. _____

1st 24 hrs. after shot _____

Gas _____ Cu. Ft.

Dry Hole _____

Abandoned _____

Date

DEC 8 1948

19

S. I. LEWIS Scout

Map No. 71 Sec. 6 Twp. 12 R. 18WWell No. 1 HarmanPetroleum Inc. Company
ABANDONED

Contractor

NE NW

E12125
SECTION PLAT330 Ft. from N. Line Ft. from S. Line330 Ft. from E. Line Ft. from W. Line

Ellis County

	0		

Location Rig up

Drilling and Remarks:

Cer 3725**RECORD**Cased in., ft.Sand Gas Oil Total Depth 3255**PRODUCTION**1st 24 hrs. Nat. 1st 24 hrs. after shot Gas Cu. Ft.Dry Hole Abandoned

Date

DEC 29 1948S. J. LEWIS Scout