

Ellis

KANSAS

FORM 51 25M 3-49 PETROL

Section 7 Township 12 Range 17W

Well No. #1 Karlin

Company B & R Drlg.

NORTH

WEST

EAST

|   |   |  |  |  |  |  |  |
|---|---|--|--|--|--|--|--|
|   |   |  |  |  |  |  |  |
| 0 | . |  |  |  |  |  |  |
|   |   |  |  |  |  |  |  |
|   |   |  |  |  |  |  |  |
SOUTH

Ellis

KANSAS

Sec. 7- Twp. 12 R. 17W

Well No. #1 Karlin Farm

B&R Drlg. Company


Contractor

660 Ft. from N. Line

Ft. from S. Line

Ft. from E. Line

330 Ft. from W. Line  
C W L NW NW

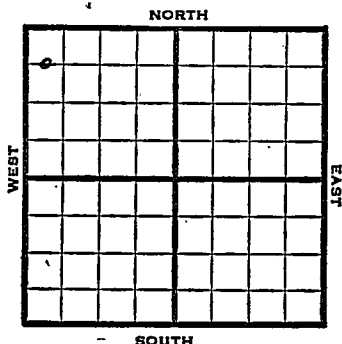

1952 Elev. 2138' REPORT

10/1 Location

10/8 8" @ 205  
Drlg. 2730'

10/15 Heeb 3348, Lans 3394  
DST 3423-93, 1 hr., 135' GCM  
Arb 3670  
Drlg. 3674'

10/22 DST 3683-90, 1 hr., 210' oil, 90'  
muddy oil 925# RTD 3740  
5" @ 3739'

10/29 CO 3740' Set plug 3734' 12/3709-13  
HFW Set plug 3704' 6/3695-97  
6/3697-99 CO 6/3699-3708 4 BWPH  
Set plug 3691 12/3683-86 S/2 1/4 BOPH  
500 A S/20 BOPH plus 2% wtr.  
1000' off btm. POP

11/5 NR

11/12 "

11/20 "

11/27 "

12/4 POP P/100% wtr

12/11 " " "

12/18 NR

OVER

1952

12/23

Spud 9-30-52

D & A TD 3740' 8" @ 205'

Anhy 1385' Heeb 3348' Lans. 3394'

DST 3423-93 open 1 hr, rec 135' GCM

Arb. 3670'

DST 3683-90 open 1 hr, rec 210' oil,

90' muddy oil, 925#. TD 3740'

5" @ 3739 CO to 3740 SP 3734

12/3709-13 HFW SP 3704 6/3695-97

6/3697-99 6/3699-3708 4 BWPH

SP 3691 12/3683-85 S/2 $\frac{1}{4}$  BOPH

500 A S/20 BOPH 2% wtr. SP 3690

S/20 BOPH 20% wtr. wtr. dec.

P/all wtr.

D & A

**ABANDONED**

County Ellis State KansasSec. 7 (Blk. Twp.) 12 (Sur. Rge.) 17W Map No.Operator B & R Drig.Well No. 1 Farm KarlinElev. Location C W L NW NW

|   |  |  |  |  |  |  |  |  |  |
|---|--|--|--|--|--|--|--|--|--|
| 0 |  |  |  |  |  |  |  |  |  |
|   |  |  |  |  |  |  |  |  |  |
|   |  |  |  |  |  |  |  |  |  |
660 Ft. From N Line NW330 Ft. From V Line Quarter1st. Report OCT 1 1952

Completion

Remarks

Spudding Date

Drig. Data

Location


J. G. McGEHEE

County Ellis State Kansas  
 Sec. 7 (Blk. Twps.) 12 (Sur. Rge.) 17W Map No.

Operator B & R Drlg.

Well No. 1 Farm Karlin

Elev. 2138 Location C W L NW NW

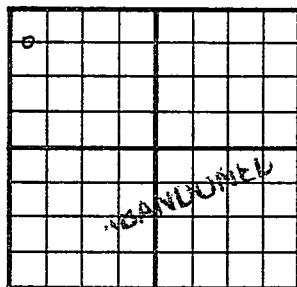

660 Ft. From N Line NW

330 Ft. From W Line Quarter

1st. Report

Completion DEC 23 1952

Remarks

Spudding Date 9-30-52

Drlg. Data D & A TD 3740

8" @ 205 Anhv 1385 Heeb. 3348

Lans. 3394 DST 3423-93 open 1 hr.

Rec. 135' gcm Arb. 3670 DST 3683-90

open 1 hr. Rec. 210' oil 90' muddy oil

925# TD 3740 5" @ 3739 CO to 3740

SP 3734 12/ 3709-13 HFW SP 3704

16/ 3695-97 6/ 3697-99 6/ 3699-3708

4 bwph SP 3691 12/ 3683-85

S/ 2 1/4 boph 500 A S/ 20 boph 2% wtr.

SP 3690 S/ 20 boph 20% wtr.

wtr. dec. P/ all wtr.

D & A

J. G. MCGEHEE